

JACKSON
M 191
10-31-72

MISSISSIPPI
 BOARD OF WATER COMMISSIONERS
 416 North State Street
 Jackson, Mississippi 39201


WATER WELL DRILLERS LOG

Oct 31 19 72 Colville Water Supply Jackson
 date well completed firm name county well located

LANDOWNER: <u>Cleo Jones</u>	description of formations encountered	from	to
<u>Wolf Ridge Ms</u> (mailing address)	<u>clay</u>	<u>0</u>	<u>48</u>
	<u>gravel</u>	<u>48</u>	<u>90</u>
	<u>clay</u>	<u>90</u>	<u>168</u>
	<u>sand</u>	<u>168</u>	<u>195</u>
WELL LOCATION: sec. <u>7</u> T. <u>6</u> N. R. <u>5</u> E. <u>10</u> miles <u>North</u> of <u>NP</u> (distance) (direction) (nearest town)			
WELL PURPOSE: <u>home</u> (home, irrigation, municipal, industrial)			
WELL COMPLETION DATA: (1) diameter (inches) <u>2</u> (2) total depth (feet) <u>195</u> (3) static water level (feet) <u>20</u> <u>below</u> above top of ground. (4) casing <u>galv</u> <u>190</u> (material) (depth) <u> </u> if telescope see back. (size) (5) screen <u>5'</u> <u>190</u> (length) (depth to top) <u>2</u> <u>stainless</u> (size) (material) (6) pump _____ (HP) _____ (yield gpm) (type power) (7) electric log _____ (yes or no) (organization running log) (8) how well bottom plugged _____			
DRILLERS REMARKS: <u>pump installed by owner</u>			

If well telescopes please sketch and show depths.

GROUND LEVEL

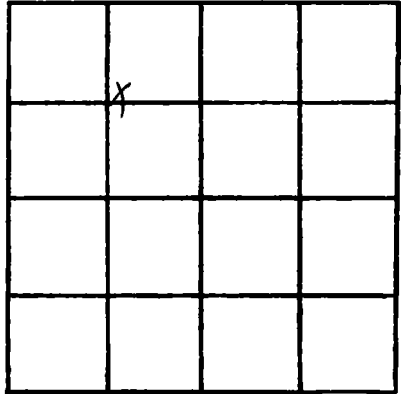

SECTION 7

Please indicate well location X.

ADDITIONAL INFORMATION

If more than one screen, show locations of each on sketch.