

JACKSON
 M 196
 12-30-72

MISSISSIPPI
 BOARD OF WATER COMMISSIONERS
 416 North State Street
 Jackson, Mississippi 39201

CODED

WATER WELL DRILLERS LOG

12-30 1972 Colville Water Supply JACKSON
 date well completed firm name county well located

LANDOWNER: Clifford Allen
 Helena, Miss.
 (mailing address)

description of formations encountered	from	to
clay	0	48
sand	48	65
clay	65	

WELL LOCATION:
 sec. 23 T. 6 N. R. 5 E
 6 miles NE. of M.P.
 (distance) (direction) (nearest town)

WELL PURPOSE: home
 (home, irrigation, municipal, industrial)

WELL COMPLETION DATA:

(1) diameter (inches) 2

(2) total depth (feet) 237

(3) static water level (feet) 6 below above top of ground.

(4) casing galv 232
 (material) (depth)

(size) if telescope see back.

(5) screen 5 232
 (length) (depth to top)

2" Stam
 (size) (material)

(6) pump (HP) (yield gpm)

(type power)

(7) electric log no
 (yes or no)

(organization running log)


(8) how well bottom plugged CP Vaby

CODED

DRILLERS REMARKS: Pump installed by owner

If well telescopes please sketch and show depths.

GROUND LEVEL

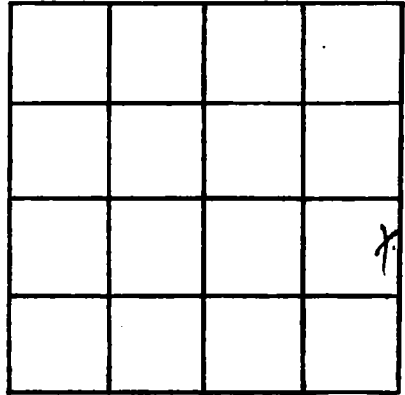

SECTION 32

Please indicate well location X.

ADDITIONAL INFORMATION

If more than one screen, show locations of each on sketch.