

JACKSON
 M 197
 9-20-72

MISSISSIPPI
 BOARD OF WATER COMMISSIONERS
 416 North State Street
 Jackson, Mississippi 39201

CODED

WATER WELL DRILLERS LOG

9-20 1972 Blville Water Supply JACKSON
 date well completed firm name county well located


LANDOWNER: <u>Charles Williams</u>	description of formations encountered	from	to
<u>Big Point Ms</u> (mailing address)	<u>pipe clay</u>	<u>0</u>	<u>30</u>
	<u>sand</u>	<u>31</u>	<u>114</u>
	<u>clay</u>	<u>114</u>	<u>262</u>
	<u>sand</u>	<u>262</u>	<u>283</u>
	<u>clay</u>	<u>283</u>	<u>493</u>
	<u>sand</u>	<u>493</u>	<u>540</u>
	<u>clay</u>	<u>540</u>	<u>682</u>
	<u>sand</u>	<u>682</u>	<u>703</u>
WELL LOCATION:			
sec <u>7</u> T <u>6</u> N R <u>5</u> E			
<u>9</u> miles <u>NE</u> of <u>M.P.</u>			
(distance) (direction) (nearest town)			
WELL PURPOSE: <u>home</u>			
(home, irrigation, municipal, industrial)			
WELL COMPLETION DATA:			
(1) diameter (inches) <u>2</u>			
(2) total depth (feet) <u>703</u>			
(3) static water level (feet) <u>10</u> <u>below</u> top of ground.			
(4) casing <u>galv</u> , <u>693</u> , (material) (depth)			
_____ If telescope see back. (size)			
(5) screen <u>10</u> , <u>693</u> (length) (depth to top)			
<u>2"</u> , <u>Stainless</u> (size) (material)			
(6) pump _____ (HP) (yield gpm)			
_____ (type power)			
(7) electric log <u>no</u> (yes or no)			
_____ (organization running log)			
(8) how well bottom plugged <u>BP done</u>			
DRILLERS REMARKS: <u>pump installed by owner</u>			

CODED

APR 4 1972

If well telescopes please sketch and show depths.

GROUND LEVEL

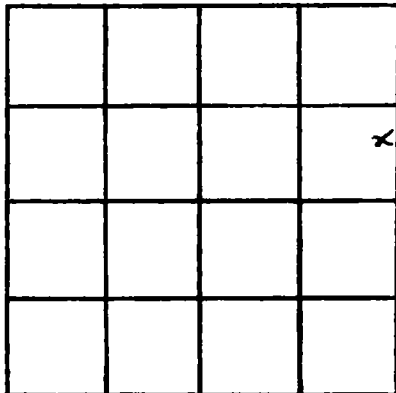

SECTION _____

Please indicate well location X.

ADDITIONAL INFORMATION

If more than one screen, show locations of each on sketch.