

JACKSON
M 199
8-7-72

MISSISSIPPI
BOARD OF WATER COMMISSIONERS
416 North State Street
Jackson, Mississippi 39201

WATER WELL DRILLERS LOG

COPIED

Aug 7 1972 Colville Water Supply JACKSON
date well completed firm name county well located


LANDOWNER: <u>LARRY</u>	description of formations encountered	from	to
<u>Young</u> <u>HELENA Ms</u> (mailing address)	<u>Clay</u> <u>SAND</u>	<u>0</u> <u>22</u>	<u>22</u> <u>85</u>
WELL LOCATION:			
sec. <u>8</u> T. <u>6</u> N. R. <u>5</u> E <u>8</u> miles <u>N.E.</u> of <u>M.P.</u> (distance) (direction) (nearest town)			
WELL PURPOSE: <u>HOME</u> (home, irrigation, municipal, industrial)			
WELL COMPLETION DATA:			
(1) diameter (inches) <u>2</u>			
(2) total depth (feet) <u>85</u>			
(3) static water level (feet) <u>12</u> <u>below</u> above top of ground.			
(4) casing <u>plastic</u> <u>80</u> (material) (depth)			
(size) if telescope see back.			
(5) screen <u>5</u> <u>80</u> (length) (depth to top)			
<u>2</u> <u>plastic</u> (size) (material)			
(6) pump <u>1/2</u> <u>10</u> (HP) (yield gpm)			
<u>elec</u> (type power)			
(7) electric log <u>NO</u> (yes or no)			
(organization running log)			
(8) how well bottom plugged <u>BPlugged</u>			
DRILLERS REMARKS:			

COPIED

SPR 4

If well telescopes please sketch and show depths.

GROUND LEVEL

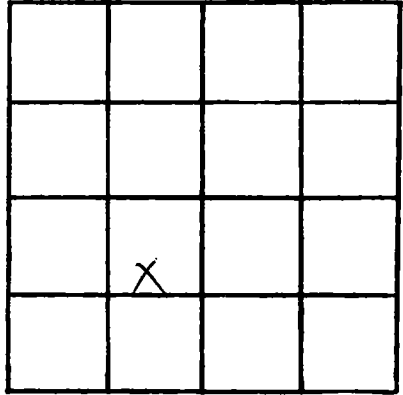

SECTION 8

Please indicate well location X.

ADDITIONAL INFORMATION

If more than one screen, show locations of each on sketch.