

JACKSON  
M200  
12-14-72

MISSISSIPPI  
BOARD OF WATER COMMISSIONERS  
416 North State Street  
Jackson, Mississippi 39201

**CODED**

WATER WELL DRILLERS LOG


12-14 date well completed    1972 Poloille Water Supply firm name    JACKSON county well located

LANDOWNER: <u>Roger Yates</u>	description of formations encountered	from	to
<u>Big Point Ms</u> (mailing address)	<u>clay sand</u>	<u>0</u>	<u>47</u> <u>47</u> <u>89</u>
<b>WELL LOCATION:</b> sec <u>7</u> T <u>6</u> N R <u>5</u> E <u>7 1/2</u> miles <u>North</u> of <u>M.P.</u> (distance) (direction) (nearest town)			
<b>WELL PURPOSE:</b> <u>home</u> (home, irrigation, municipal, industrial)			
<b>WELL COMPLETION DATA:</b> (1) diameter (inches) <u>2</u> (2) total depth (feet) <u>89</u> (3) static water level (feet) <u>18-6</u> <sup>below</sup> / <sub>above</sub> top of ground. (4) casing <u>galv</u> <u>84</u> (material) (depth) (size) If telescope see back. (5) screen <u>5</u> <u>84</u> (length) (depth to top) <u>2"</u> <u>stain</u> (size) (material) (6) pump <u>1/2</u> <u>.12</u> (HP) (yield gpm) <u>elec</u> (type power) (7) electric log <u>no</u> (yes or no) (organization running log) (8) how well bottom plugged <u>BP Valve</u>			
<b>DRILLERS REMARKS:</b>			

**CODED**

If well telescopes please sketch and show depths.

GROUND LEVEL

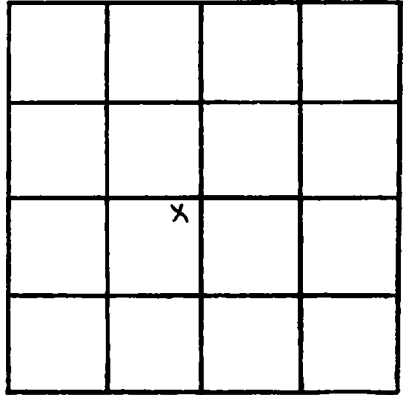

SECTION 7

Please indicate well location X.

ADDITIONAL INFORMATION

If more than one screen, show locations of each on sketch.