

JACKSON
 M 201
 12-28-72

MISSISSIPPI
 BOARD OF WATER COMMISSIONERS
 416 North State Street
 Jackson, Mississippi 39201

CODED

WATER WELL DRILLERS LOG

dec 28 1972 Colville Water Supply Jackson
 data well completed firm name county well located

LANDOWNER: John
 Huddleston
 Helena Ms
 (mailing address)

description of formations encountered	from	to
	clay	0
sand	18	69
clay	69	240
sand clay	240	258

WELL LOCATION:
 sec 29 T 6 N R 5 E
 5 miles NE of MP
 (distance) (direction) (nearest town)

WELL PURPOSE: home
 (home, irrigation, municipal, industrial)

WELL COMPLETION DATA:

(1) diameter (inches) 2"
 (2) total depth (feet) 258
 (3) static water level (feet) 8 below top of ground.
 (4) casing galv 253 (material) (depth)
 (size) If telescope see back.
 (5) screen 5' 253 (length) (depth to top)
 2" stam (size) (material)
 (6) pump 1 15 (HP) (yield gpm)
 elec (type power)
 (7) electric log no (yes or no)
 (organization running log)
 (8) how well bottom plugged BPDalv

CODED


DRILLERS REMARKS:

APR 4 1973

MISS. Bd. of
 WATER COMMISSIONERS

If well telescopes please sketch and show depths.

GROUND LEVEL

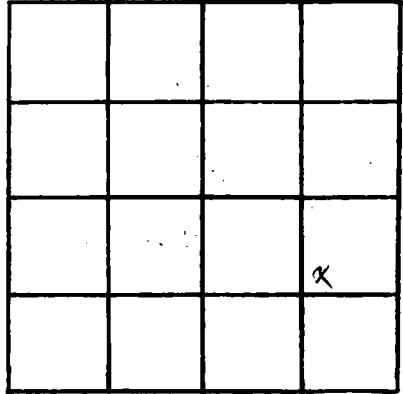

SECTION 29

Please indicate well location X.

ADDITIONAL INFORMATION

If more than one screen, show locations of each on sketch.