

CODED

JACKSON
M 203
10-16-72

MISSISSIPPI
BOARD OF WATER COMMISSIONERS
416 North State Street
Jackson, Mississippi 39201

WATER WELL DRILLERS LOG

Oct 16

1972 Colville Water Supply

JACKSON

date well completed

firm name

county well located


LANDOWNER: <u>Blyna DAVIS</u>	description of formations encountered	from	to
<u>Helena Ms</u> (mailing address)	<u>Sandy Clay</u>	<u>0</u>	<u>16</u>
WELL LOCATION: sec <u>29</u> T <u>6</u> N R <u>5</u> E <u>5</u> miles <u>NE</u> of <u>Miss Point</u> (distance) (direction) (nearest town)	<u>SAND</u>	<u>16</u>	<u>55</u>
WELL PURPOSE: <u>home</u> (home, irrigation, municipal, industrial)	<u>Clay</u>	<u>55</u>	<u>106</u>
WELL COMPLETION DATA: (1) diameter (inches) <u>2</u> (2) total depth (feet) <u>149</u> (3) static water level (feet) <u>12</u> <u>below</u> above top of ground. (4) casing <u>3/4" 144</u> (material) (depth) (size) if telescope see back. (5) screen <u>5' 144</u> (length) (depth to top) <u>2" STAINLESS</u> (size) (material) (6) pump <u>1/2 10</u> (HP) (yield gpm) <u>elec</u> (type power) (7) electric log <u>NO</u> (yes or no) (organization running log) (8) how well bottom plugged <u>B.P. Valve</u>	<u>SAND</u>	<u>106</u>	<u>149</u>
DRILLERS REMARKS:			

CODED

NOV 4 1972

If well telescopes please sketch and show depths.

GROUND LEVEL

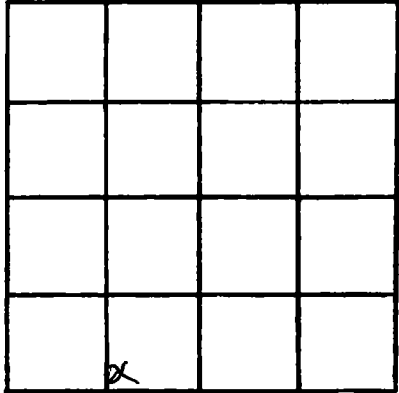

SECTION 29

Please indicate well location X.

ADDITIONAL INFORMATION

If more than one screen, show locations of each on sketch.