

JACKSON
M 204
8-21-72

MISSISSIPPI
BOARD OF WATER COMMISSIONERS
416 North State Street
Jackson, Mississippi 39201

CODED

WATER WELL DRILLERS LOG


Aug 21 1972 Colville Water Supply Jackson
drillers well completed firm name county well located

LANDOWNER: <u>HURLEY</u>	description of formations encountered	from	to
<u>Prassenos Prassenos</u>			
<u>Hurley Ms.</u> (mailing address)	<u>Sand</u>	<u>0</u>	<u>140</u>
	<u>Clay</u>	<u>140</u>	<u>200</u>
	<u>SAND</u>	<u>200</u>	<u>295</u>
	<u>Clay</u>	<u>226</u>	<u>267</u>
	<u>SAND</u>	<u>267</u>	<u>288</u>
	<u>Clay</u>	<u>288</u>	<u>361</u>
	<u>SAND</u>	<u>361</u>	<u>403</u>
	<u>Clay</u>	<u>403</u>	<u>609</u>
	<u>SAND</u>	<u>609</u>	<u>619</u>
	<u>Clay</u>	<u>619</u>	<u>677</u>
WELL LOCATION: sec <u>16</u> T <u>6</u> N R <u>5</u> E <u>10</u> miles <u>SE</u> of <u>Hurley</u> (distance) (direction) (nearest town)			
WELL PURPOSE: <u>Home</u> (home, irrigation, municipal, industrial)			
WELL COMPLETION DATA: (1) diameter (inches) <u>2</u>			
(2) total depth (feet) <u>677</u>			
(3) static water level (feet) <u>12</u> <u>below</u> <u>above</u> top of ground.			
(4) casing <u>galv</u> , <u>662</u> , (material) (depth)			
(size) If telescope see back.			
(5) screen <u>15'</u> , <u>662</u> (length) (depth to top)			
<u>2</u> , <u>STAINLESS</u> (size) (material)			
(6) pump _____ (HP) _____ (yield gpm)			
(type power)			
(7) electric log <u>no</u> (yes or no)			
(organization running log)			
(8) how well bottom plugged <u>BP Valve</u>			
DRILLERS REMARKS: <u>pump installed by owner</u>			

CODED

If well telescopes please sketch and show depths.

GROUND LEVEL

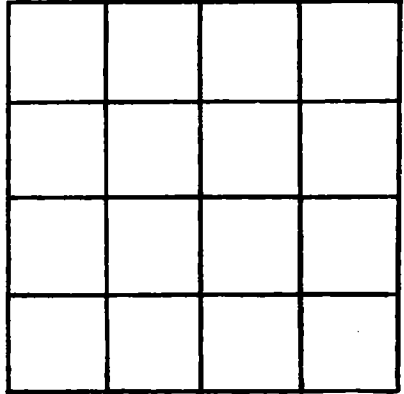

SECTION 12

Please indicate well location X.

ADDITIONAL INFORMATION

Located on a dirt road not shown on map. Estimated by mileage.

If more than one screen, show locations of each on sketch.