

JACKSON
 MZ10
 4-19-73

MISSISSIPPI
 BOARD OF WATER COMMISSIONERS
 416 North State Street
 Jackson, Mississippi 39201

CODED

WATER WELL DRILLERS LOG


4-19 1973 Columbia Water Supply Jackson
 date well completed firm name county well located

LANDOWNER: <u>Robert Logan</u> <u>Helena, MS</u> (mailing address)	description of formations encountered	from	to
WELL LOCATION: sec. <u>31</u> T. <u>6</u> N. R. <u>5</u> E <u>4 1/2</u> miles <u>NE</u> of <u>Meridian</u> (distance) (direction) (nearest town)	<u>pink clay</u> <u>sand</u> <u>clay</u> <u>mud</u>	<u>0</u> <u>18</u> <u>88</u> <u>220</u>	<u>18</u> <u>88</u> <u>220</u> <u>240</u>
WELL PURPOSE: <u>fish pond</u> (home, irrigation, municipal, industrial)			
WELL COMPLETION DATA: (1) diameter (inches) <u>4</u> (2) total depth (feet) <u>240</u> (3) static water level (feet) <u>17-12</u> ^{below} above top of ground. (4) casing <u>steel</u> , <u>230</u> (material) (depth) (size) if telescope see back. (5) screen <u>10'</u> , <u>230</u> (length) (depth to top) <u>4"</u> , <u>stainless</u> (size) (material) (6) pump <u>3</u> , <u>60</u> (HP) (yield gpm) <u>elec</u> (type power) (7) electric log <u>no</u> (yes or no) (organization running log) (8) how well bottom plugged <u>B-Value</u>			
DRILLERS REMARKS:			

CODED

If well telescopes please sketch and show depths.

GROUND LEVEL

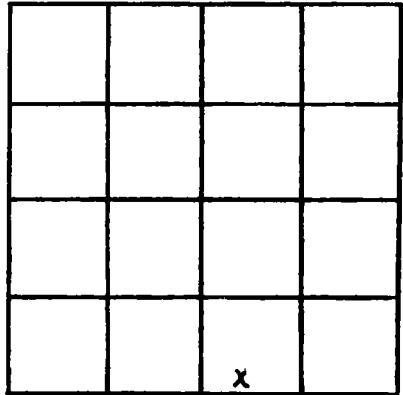

SECTION 31

Please indicate well location X.

ADDITIONAL INFORMATION

If more than one screen, show locations of each on sketch.