

JACKSON
M211
10-9-73

MISSISSIPPI BOARD OF WATER COMMISSIONERS **CODED**
416 North State Street
Jackson, Mississippi 39201

WATER WELL DRILLERS LOG

Oct 9 1973 Colwell Water Supply Jackson
date well completed firm name county well located


LANDOWNER:	description of formations encountered	from	to
<u>Christine Person</u>			
<u>Helena Ma.</u> (mailing address)	<u>shell</u>	<u>21</u>	<u>145</u>
WELL LOCATION:	<u>clay</u>	<u>145</u>	<u>170</u>
sec. <u>22</u> T. <u>6</u> N. R. <u>5</u> E.	<u>sand</u>	<u>170</u>	<u>195</u>
<u>8</u> miles <u>NE</u> of <u>M.P.</u>			
(distance) (direction) (nearest town)			
WELL PURPOSE: <u>home</u> (home, irrigation, municipal, industrial)			
WELL COMPLETION DATA:			
(1) diameter (inches) <u>2</u>			
(2) total depth (feet) <u>195</u>			
(3) static water level (feet) <u>30</u> <u>below</u> above top of ground.			
(4) casing <u>galv.</u> <u>190</u> (material) (depth)			
(size) if telescope see back.			
(5) screen <u>5'</u> <u>190</u> (length) (depth to top)			
<u>2</u> <u>stainless</u> (size) (material)			
(6) pump <u>1/2</u> <u>10</u> (HP) (yield gpm)			
<u>elec</u> (type power)			
(7) electric log <u>no</u> (yes or no)			
(organization running log)			
(8) how well bottom plugged <u>B.P. Value</u>			
DRILLERS REMARKS:			

CODED

DEC 21 1973

If well telescopes please sketch and show depths.

GROUND LEVEL

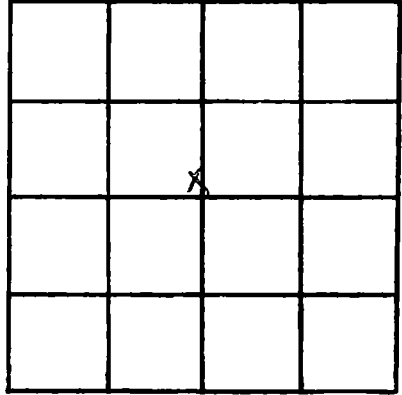

SECTION _____

Please indicate well location X.

ADDITIONAL INFORMATION

If more than one screen,
show locations of each on sketch.