

JACKSON
M212
10-1-73

MISSISSIPPI
BOARD OF WATER COMMISSIONERS **CODED**
416 North State Street
Jackson, Mississippi 39201

WATER WELL DRILLERS LOG

Oct 1 1973 Calvick Water Supply Jackson
date well completed firm name county well located

LANDOWNER: J. J. Wildman
Helena 4Ms
(mailing address)

description of formations encountered	from	to
<u>sand</u>	<u>0</u>	<u>21</u>
<u>soft clay</u>	<u>21</u>	<u>30</u>
<u>sand</u>	<u>30</u>	<u>95</u>
<u>clay</u>	<u>95</u>	<u>132</u>
<u>sand</u>	<u>132</u>	<u>153</u>

WELL LOCATION:
sec. 22 T. 6 N R. 5 E
8 miles NE of Albany
(distance) (direction) (nearest town)

WELL PURPOSE: home
(home, irrigation, municipal, industrial)

CODED

WELL COMPLETION DATA:

(1) diameter (inches) 2

(2) total depth (feet) 153

(3) static water level (feet) 3 below above top of ground.

(4) casing Galv 148
(material) (depth)
(size) if telescope see back.

(5) screen 5 148
(length) (depth to top)
2 standard
(size) (material)

(6) pump 1 20
(HP) (yield gpm)
elec
(type power)

(7) electric log no
(yes or no)
(organization running log)


(8) how well bottom plugged BP Valve

DEC 21 1973

DRILLERS REMARKS:

If well telescopes please sketch and show depths.

GROUND LEVEL

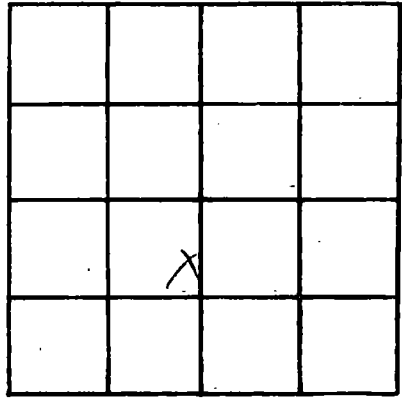

SECTION 22

Please indicate well location X.

ADDITIONAL INFORMATION

If more than one screen, show locations of each on sketch.