

JACKSON
M213
4-13-73

MISSISSIPPI
BOARD OF WATER COMMISSIONERS
416 North State Street
Jackson, Mississippi 39201

CODED

WATER WELL DRILLERS LOG

4-13

1973 Colville Water Supply Jackson

date well completed

firm name

county well located

LANDOWNER: Jerry

Price

description of formations encountered

from

to

Sandy clay

0 27

Sand

27 90

Clay

90 111

Sand

111 153

Orange Grove Ms.
(mailing address)

WELL LOCATION:

sec. 31 T. 6 N R. 5 E
5 miles East of M.P.
(distance) (direction) (nearest town)

WELL PURPOSE:

(home, irrigation, municipal, industrial)

CODED

WELL COMPLETION DATA:

- (1) diameter (inches) 2
- (2) total depth (feet) 153
- (3) static water level (feet) 1'-6" below top of ground.
- (4) casing galv. (material), (depth), (size) if telescope see back.
- (5) screen 5' 148 (length), (depth to top)
2" (size), stainless (material)
- (6) pump 1/2 (HP), 10 (yield gpm)
elec (type power)
- (7) electric log no (yes or no)

(organization running log)


(8) how well bottom plugged BP Valve

DRILLERS REMARKS:

DEC 21 1973

If well telescopes please sketch and show depths.

GROUND LEVEL

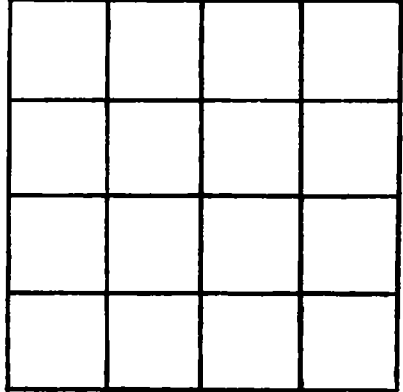

SECTION _____

Please indicate well location X.

ADDITIONAL INFORMATION

If more than one screen, show locations of each on sketch.