

JACKSON
M214
4-12-73

MISSISSIPPI
BOARD OF WATER COMMISSIONERS
416 North State Street
Jackson, Mississippi 39201

CODED

WATER WELL DRILLERS LOG

4-12-1973 date well completed
Columbia Water Supply firm name
Jackson county well located

LANDOWNER: P. D. Baugh
Orange Grove Ms
(mailing address)

description of formations encountered	from	to
Sand	0	111
Clay	111	146
Sand	146	174
Clay	174	258
Sand	258	322

WELL LOCATION:
sec. 20 T. 6 N. R. 4 E
1.0 miles NE of Moss Point
(distance) (direction) (nearest town)

WELL PURPOSE: home
(home, irrigation, municipal, industrial)

CODED

WELL COMPLETION DATA:

(1) diameter (inches) 2

(2) total depth (feet) 322

(3) static water level (feet) 15 below top of ground.

(4) casing Galv. 317 (material) (depth)

(size) if telescope see back.

(5) screen 5 322 (length) (depth to top)

2" STAIN (size) (material)

(6) pump No pump needed (HP) (yield gpm)

(type power)

(7) electric log No (yes or no)

(organization running log)


(8) how well bottom plugged BP Valve

DEC 21 1973

DRILLERS REMARKS:

If well telescopes please sketch and show depths.

GROUND LEVEL

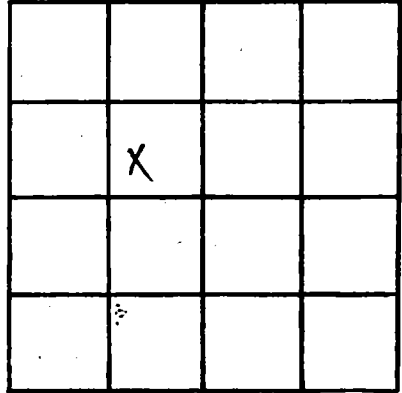

SECTION 20

Please indicate well location X.

ADDITIONAL INFORMATION

If more than one screen,
show locations of each on sketch.