

JACKSON
M215
10-13-73

MISSISSIPPI BOARD OF WATER COMMISSIONERS **CODED**
416 North State Street
Jackson, Mississippi 39201

WATER WELL DRILLERS LOG

Oct 13 1973 Colville Water Supply Jackson
date well completed firm name county well located

LANDOWNER: J. C. ...
Ray
Helena Ms
(mailing address)

description of formations encountered	from	to
clay	0	21
sand	21	41
clay	41	257
sand	257	279

WELL LOCATION:
sec. 33 T. 6 N R. 5 E
7 miles NE of M.P.
(distance) (direction) (nearest town)

WELL PURPOSE: home
(home, irrigation, municipal, industrial)

WELL COMPLETION DATA:

(1) diameter (inches) 2

(2) total depth (feet) 279

(3) static water level (feet) 16 below top of ground.

(4) casing galv 274
(material) (depth)

(size) if telescope see back.

(5) screen 5' 274
(length) (depth to top)

2" standist
(size) (material)

(6) pump 1/2 10
(HP) (yield gpm)

elec
(type power)

(7) electric log no
(yes or no)

(organization running log)

(8) how well bottom plugged BP Valve


CODED

DEC 21 1973

DRILLERS REMARKS:

If well telescopes please sketch and show depths.

GROUND LEVEL

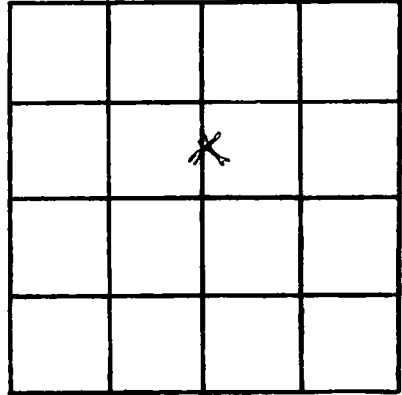

SECTION 33

Please indicate well location X.

ADDITIONAL INFORMATION

If more than one screen, show locations of each on sketch.