

JACKSON
M 217
5-29-73

MISSISSIPPI
BOARD OF WATER COMMISSIONERS
416 North State Street
Jackson, Mississippi 39201

CODED

WATER WELL DRILLERS LOG

5/29 1973 Coast Water Well Jackson
date well completed firm name county well located

LANDOWNER: Roberta Homes

description of formations encountered

from to

P.O. Box 266

top soil & w. clay 0 22

~~Escatoupa, Mo.~~ Escatoupa, Mo.
(mailing address)

sand - fine to med. 22 113

WELL LOCATION:

blue clay 113 130

sec. 29 T 6 N R. 5 E
S W

sand - fine to med. 130 145

6 miles N. of Missport
(distance) (direction) (nearest town)

blue clay 145 230

WELL PURPOSE: Subsidence
(home, irrigation, municipal, industrial)

sand - med. 230 270

WELL COMPLETION DATA:

(1) diameter (inches) 4"
(2) total depth (feet) 270'
(3) static water level (feet) 21 below
top of ground.

(4) casing P.V.C., 260'
(material) (depth)

CODED

4"
(size) if telescope see back.

(5) screen 10', 260'
(length) (depth to top)

2", stainless steel
(size) (material)

(6) pump 1 30
(HP) (yield gpm)

elec.
(type power)

(7) electric log NO
(yes or no)

(organization running log)

(8) how well bottom plugged


By Well

DRILLERS REMARKS:


FEB 1 1974

MISS. BD. OF WATER COMM

If well telescopes please sketch and show depths.

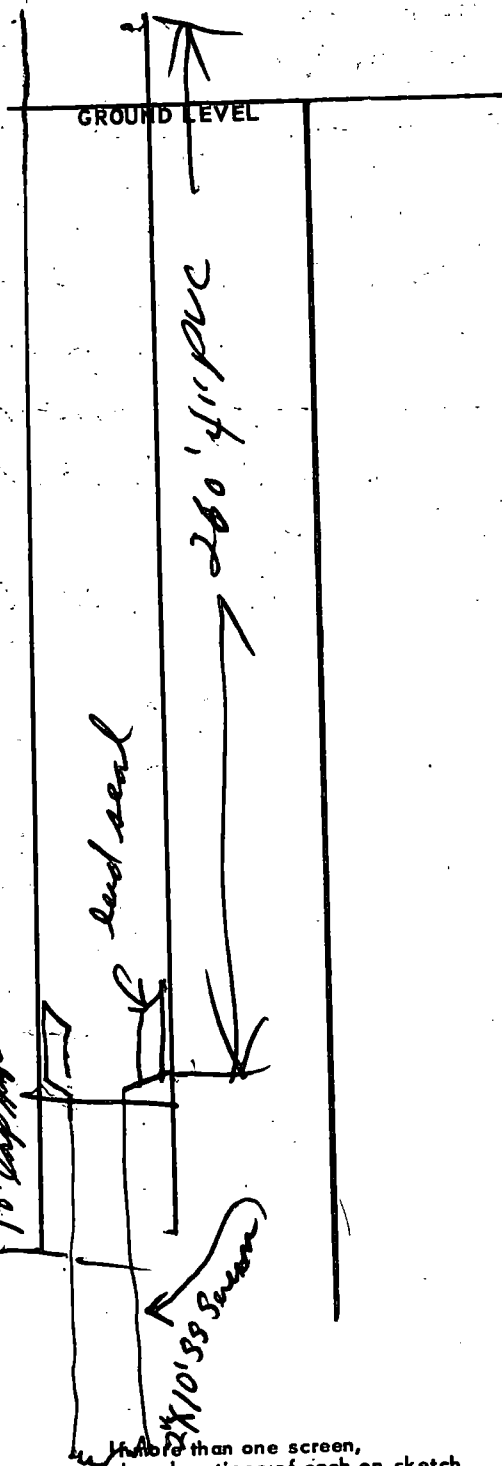

If more than one screen, show locations of each on sketch.

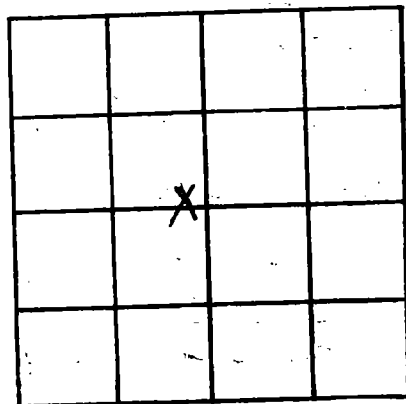

SECTION 29

Please indicate well location X.

ADDITIONAL INFORMATION

Lined area for additional information.