

JACKSON
M219
4-19-74

MISSISSIPPI
BOARD OF WATER COMMISSIONERS **CODED**
416 North State Street
Jackson, Mississippi 39201

WATER WELL DRILLERS LOG

April 19 1974 Colville Water Sys. Jackson
date well completed firm name county well located

LANDOWNER: James Williamson
Helena, Miss.
(mailing address)


WELL LOCATION:
sec. 26 6 N R. 5 E
7 miles N/E of M.P.
(distance) (direction) (nearest town)

WELL PURPOSE: Home
(home, irrigation, municipal, industrial)

- WELL COMPLETION DATA:
- (1) diameter (inches) 7
 - (2) total depth (feet) 219
 - (3) static water level (feet) 13 below above top of ground.
 - (4) casing Plastic 214,
(material) (depth)
 - (size) if telescope see back.
 - (5) screen 5', 214
(length) (depth to top)
 - 2, Plastic
(size) (material)
 - (6) pump 1, 15
(HP) (yield gpm)
 - else
(type power)
 - (7) electric log no
(yes or no)
 - (organization running log)
 - (8) how well bottom plugged BP 100%

description of formations encountered	from to	
Clay	0	50
sand	50	55
Clay	55	105
Gravel	105	176
Clay	176	181
Sand	181	219

CODED

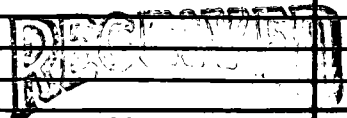


SEP 30 1974

DRILLERS REMARKS:

If well telescopes please
sketch and show depths.

GROUND LEVEL

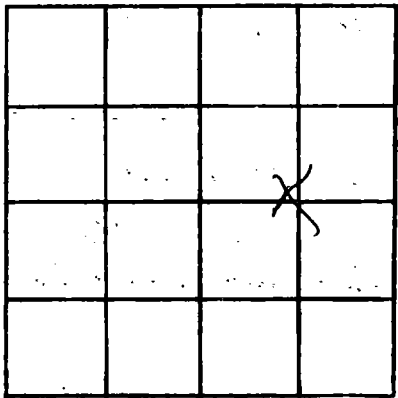

SECTION 26

Please indicate well location X.

ADDITIONAL INFORMATION

Lined area for providing additional information, consisting of 20 horizontal lines.

If more than one screen,
show locations of each on sketch.