

M 222
 Jackson
 5/21/75

MISSISSIPPI
 BOARD OF WATER COMMISSIONERS
 416 North State Street
 Jackson, Mississippi 39201

CODED

WATER WELL DRILLERS LOG

May 21 1975 Calville Water Sys Jackson
 date well completed firm name county well located

LANDOWNER: Jimmy
Heister
Helena Mrs.
 (mailing address)

WELL LOCATION:
 sec. 34 T. 6 N. R. 5 E
13 1/4 miles NE of MP
 (distance) (direction) (nearest town)

WELL PURPOSE: Home
 (home, irrigation, municipal, industrial)

WELL COMPLETION DATA:
 (1) diameter (inches) 2
 (2) total depth (feet) 164
 (3) static water level (feet) 0 - below
 top of ground.
 (4) casing plastic, 160,
 (material) (depth)
 (size) If telescope see back.
 (5) screen 4, 160
 (length) (depth to top)
2, plastic
 (size) (material)
 (6) pump 1/2, 8
 (HP) (yield gpm)
elec
 (type power)
 (7) electric log no
 (yes or no)
 (organization running log)
 (8) how well bottom plugged BPV

description of formations encountered	from	to
pipe clay	0	20
sand	20	60
clay	60	66
sand	66	125
clay	125	132
sand	132	164

CODED


REC-7777
 JUN 5 1975

DRILLERS REMARKS:

MISS. BD. OF WATER COMM

If well telescopes please sketch and show depths.

GROUND LEVEL

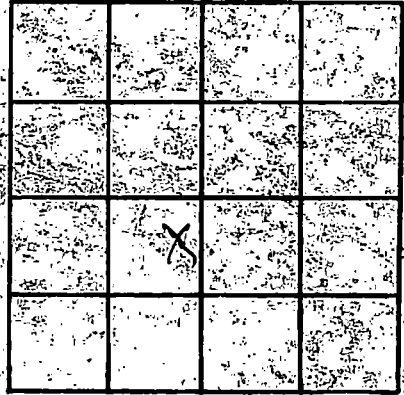

SECTION 39

Please indicate well location X.

ADDITIONAL INFORMATION

If more than one screen, show locations of each on sketch.