

M 223
 Jackson
 5/18/75

MISSISSIPPI
 BOARD OF WATER COMMISSIONERS
 416 North State Street
 Jackson, Mississippi 39201

CODED

WATER WELL DRILLERS LOG

May 18 1975 Colville Water Sys. Jackson
 date well completed firm name county well located

LANDOWNER: M. D. Osborne
 (mailing address)

WELL LOCATION:
 sec. 34 T-6 N R-5 E
 3 1/2 miles N/E of M.P.
 (distance) (direction) (nearest town)

WELL PURPOSE:
 (home, irrigation, municipal, industrial)

- WELL COMPLETION DATA:
- (1) diameter (inches) 2
 - (2) total depth (feet) 158
 - (3) static water level (feet) 0 below above top of ground
 - (4) casing plast. 153
 (material) (depth)
 (size) If telescope see back.
 - (5) screen 5 153
 (length) (depth to top)
2 plast
 (size) (material)
 - (6) pump 1 1/2 8
 (HP) (yield gpm)
elec
 (type power)
 - (7) electric log no
 (yes or no)
 (organization running log)
 - (8) how well bottom plugged Blkly

description of formations encountered	from	to
fine clay	0	18
sand	20	60
clay	60	66
sand	66	125
clay	125	132
sand	132	158

CODED


RECEIVED
 JUN 5 1975

MISS. BD. OF WATER COMM

DRILLERS REMARKS:

If well telescopes please
sketch and show depths.

GROUND LEVEL

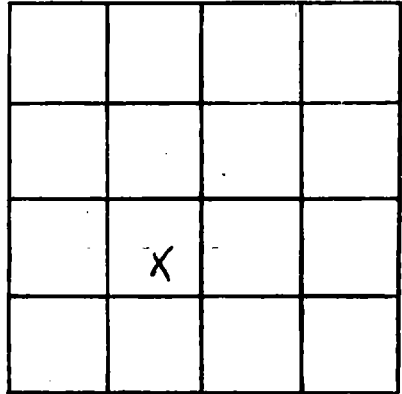

SECTION _____

Please indicate well location X.

ADDITIONAL INFORMATION

If more than one screen,
show locations of each on sketch.