

M 224
 Jackson
 5/16/75

MISSISSIPPI
 BOARD OF WATER COMMISSIONERS
 416 North State Street
 Jackson, Mississippi 39201

CODED

WATER WELL DRILLERS LOG

May 16 1975 Colville Water Sys. Jackson
 date well completed firm name county well located

LANDOWNER: John
More
Franklin Creek Ms,
 (mailing address)

description of formations encountered	from	to
<u>sandy clay</u>	<u>0</u>	<u>20</u>
<u>soft blue clay</u>	<u>20</u>	<u>44</u>
<u>clay</u>	<u>44</u>	<u>66</u>
<u>sand</u>	<u>66</u>	<u>160</u>
<u>clay</u>	<u>160</u>	<u>286</u>
<u>sand</u>	<u>286</u>	<u>396</u>

WELL LOCATION:
 sec 31 T 6 N R 4 E
9.5 miles NE of M.P.
 (distance) (direction) (nearest town)

WELL PURPOSE: home
 (home, irrigation, municipal, industrial)

CODED

- WELL COMPLETION DATA:
- (1) diameter (inches) 2"
 - (2) total depth (feet) 396
 - (3) static water level (feet) 20 ^{below} _{above} top of ground
 - (4) casing plastic 396
 (material) (depth)
 (size) if telescope see back. 396
 - (5) screen 10 396
 (length) (depth to top)
2" plastic
 (size) (material)
 - (6) pump _____ (HP) _____ (yield gpm)
 (type power)
 - (7) electric log no
 (yes or no)
 (organization running log)
 - (8) how well bottom plugged BP Vahy


RECORDED
 JUN 1975

DRILLERS REMARKS: unit installed by burner

MISS. BOARD OF WATER COMM

If well telescopes please sketch and show depths.

GROUND LEVEL

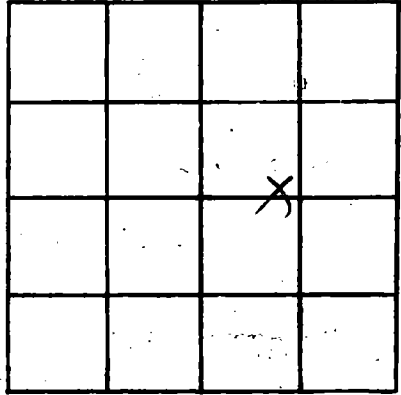

SECTION 31

Please indicate well location X.

ADDITIONAL INFORMATION

If more than one screen, show locations of each on sketch.