

M 225

JACKSON

5-26-75

MISSISSIPPI BOARD OF WATER COMMISSIONERS
416 North State Street
Jackson, Mississippi 39201

CODED

WATER WELL DRILLERS LOG

May 26 1975
date well completed

Palmer Water Sup
firm name

Jackson
county well located

PS 544 (copy) 1-18

LANDOWNER: Alice Colver
Belfountain Road, MS
(mailing address)

description of formations encountered	from	to
Brown sand	0	22
wt. rock	22	166
clay	176	352
sand	352	385

WELL LOCATION:
sec. 26 T. 6 S. R. 5 W.
6 1/2 miles North of MS.
(distance) (direction) (nearest town)

WELL PURPOSE: Domestic
(home, irrigation, municipal, industrial)

- WELL COMPLETION DATA:
- (1) diameter (inches) 2
 - (2) total depth (feet) 395
 - (3) static water level (feet) 8 below top of ground
 - (4) casing plastic 390 (material) (depth)
 - (5) screen 5 390 (length) (depth to top)
 - (6) pump 1 10 (HP) (yield gpm)
 - (7) electric log no (yes or no)
 - (8) how well bottom plugged BC Colver


DRILLERS REMARKS:

RECEIVED JUN 5 1975

MISS. BD. OF WATER COMM

If well telescopes please sketch and show depths.

GROUND LEVEL

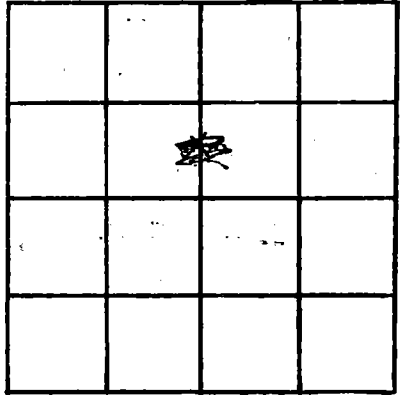

irregular sect 19
SECTION _____

Please indicate well location X.

ADDITIONAL INFORMATION

If more than one screen,
show locations of each on sketch.