

Jackson
M 226
10-27-74

MISSISSIPPI
 BOARD OF WATER COMMISSIONERS
 416 North State Street
 132 Jackson, Mississippi 39201

WATER WELL DRILLERS LOG

10/27 1974 COAST WATER WELL SERVICE Jackson
 date well completed firm name county well located

LANDOWNER: <u>W.C. Swope</u>	description of formations encountered	from	to
<u>Rt. 4 Box 332</u>			
<u>Ocean Springs, Ms</u> (mailing address)	<u>top soil</u>	<u>0</u>	<u>10</u>
	<u>coarse sand + gravel</u>	<u>10</u>	<u>170</u>

WELL LOCATION:

sec. 30 T. 6 N. R. 5 W.
4 1/2 miles NE of Osceola
 (distance) (direction) (nearest town)

WELL PURPOSE: Home
 (home, irrigation, municipal, industrial)


WELL COMPLETION DATA:

- (1) diameter (inches) 2"
- (2) total depth (feet) 170'
- (3) static water level (feet) 9 below above top of ground.
- (4) casing PVC, 160'
 (material) (depth)
- 2" If telescope see back.
 (size)
- (5) screen 10', 160'
 (length) (depth to top)
- 2", PVC
 (size) (material)
- (6) pump _____ (HP) _____ (yield gpm)
- _____ (type power)
- (7) electric log NO
 (yes or no)

_____ (organization running log)

(8) how well bottom plugged B.W.U.

DRILLERS REMARKS:

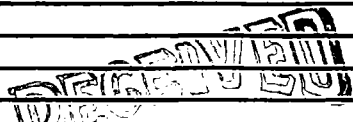


OCT 22 1975

MISSISSIPPI BOARD OF WATER COMMISSIONERS

If well telescopes please sketch and show depths.

GROUND LEVEL

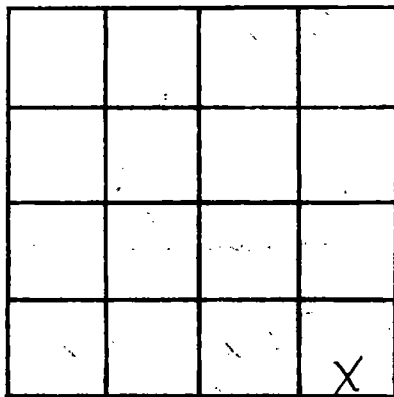

SECTION 30

Please indicate well location X.

ADDITIONAL INFORMATION

If more than one screen, show locations of each on sketch.