

Jackson
 M 227
 10/20/74

13R

MISSISSIPPI
 BOARD OF WATER COMMISSIONERS
 416 North State Street
 Jackson, Mississippi 39201

WATER WELL DRILLERS LOG

COAST. WATER WELL SERVICE

Jackson

10/20 1974
 date well completed

firm name

county well located

LANDOWNER: W. R. Myrtle
3702 Blueback Ave
Pascagoula Ms.
 (mailing address)

description of formations encountered	from	to
top soil	0	10
coarse sand + gravel	10	97
Blue clay	97	141
coarse sand	141	183
Blue clay	183	260
coarse sand	260	297
Blue clay	297	305
coarse sand	305	340

WELL LOCATION:

sec. 20 T. 6 S. R. 4 E.
11 miles N-E of Pascagoula
 (distance) (direction) (nearest town)

WELL PURPOSE: Home
 (home, irrigation, municipal, industrial)


WELL COMPLETION DATA:

- (1) diameter (inches) 2"
- (2) total depth (feet) 340
- (3) static water level (feet) 20 above top of ground. (208pm)
- (4) casing PVC (330')
 (material) (depth)
- 2" if telescope see back.
 (size)
- (5) screen 10' (330')
 (length) (depth to top)
- 2" (PVC)
 (size) (material)
- (6) pump (HP) (yield gpm)
- (type power)
- (7) electric log NO
 (yes or no)

(organization running log)


(8) how well bottom plugged B. W. 2'

DRILLERS REMARKS:

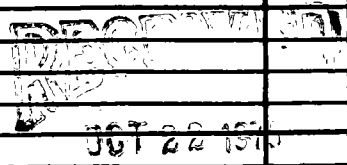

If well telescopes please sketch and show depths.

GROUND LEVEL

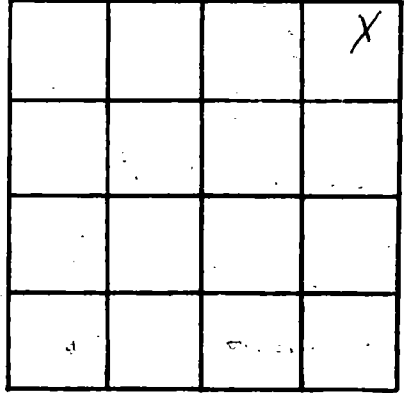

SECTION 20

Please indicate well location X.

ADDITIONAL INFORMATION

Lined area for additional information.

If more than one screen, show locations of each on sketch.