

JACKSON  
M 233  
9-1-80  
9-1-80

MISSISSIPPI  
BOARD OF WATER COMMISSIONERS  
416 North State Street  
Jackson, Mississippi 39201

CODED

WATER WELL DRILLERS LOG

date well completed 9-1-80  
firm name Coast Water Well Service, Jackson  
county well located Jackson

LANDOWNER: C. R. Sheffield  
111801 Independence Rd  
Pasadena, Miss.  
(mailing address) 39567

WELL LOCATION:  
sec. 32 T. 6 N. R. 4 W.  
6 1/2 miles NE of Moss Point  
(distance) (direction) (nearest town)

WELL PURPOSE: Home  
(home, irrigation, municipal, industrial)

WELL COMPLETION DATA:  
(1) diameter (inches) 2"  
(2) total depth (feet) 412'  
(3) static water level (feet) flow. below top of ground  
(4) casing PVC 395'  
(material) (depth)  
2" If telescope see back.  
(size)  
(5) screen 20' 392"  
(length) (depth to top)  
2" PVC  
(size) (material)  
(6) pump (HP) (yield gpm)  
Elect. (type power)  
(7) electric log No.  
(yes or no)  
N/A  
(organization running log)

description of formations encountered	from	to
Top soil	0	3
Blue Clay	3	10
White Coarse sand	10	25
White Coarse sand & wood	25	51
Blue Clay	51	117
Gray Coarse sand	117	171
Blue Clay	171	330
Gray Coarse sand	330	412

DEPT. OF NATURAL RESOURCES  
BUREAU OF LAND & WATER RESOURCES


APR - 6 1981

RECEIVED

(8) How well bottom plugged  
Pack Wash Valve  
DRILLERS REMARKS:

If well telescopes please sketch and show depths.

GROUND LEVEL

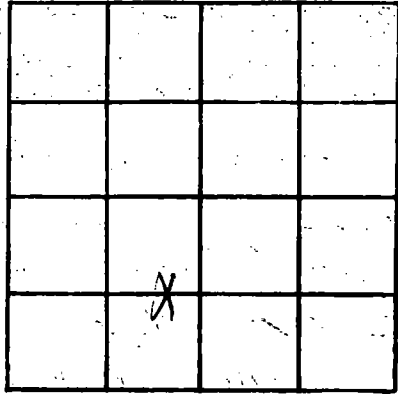

SECTION 32

Please indicate well location X.

ADDITIONAL INFORMATION

If more than one screen, show locations of each on sketch.