

MISSISSIPPI DEPARTMENT OF NATURAL RESOURCES

Bureau of Land and Water Resources

Southport Mall

P.O. Box 10631

Jackson, Mississippi 39209

WATER WELL DRILLERS LOG

RECORDED

M 236
 JACKSON, CO.
 10-15-84

10-15-84 date well completed
 19 Coors Water Well Sew. firm name
 Jackson county well located

LANDOWNER: Tomulo Jacob
 3430 Ingersoll Ave
 Pascagoula, Miss.
 (mailing address) 39567

description of formations encountered	from	to
Gray Clay	0	30'
Blue Clay	30'	45'
Coarse sand	45'	70'
Blue Clay	70'	120'
Coarse sand	120'	137'
Blue Clay	137'	193'
Coarse sand Gray	193'	220'
Blue Clay	220'	315'
Med. Coarse sand	315'	420'
5'-2" PVC Tail Pipe		

WELL LOCATION:
 sec. 31 T. 6 S. R. 4 E
 5 miles NE of Moss Point
 (distance) (direction) (nearest town)

WELL PURPOSE: None
 (home, irrigation, municipal, industrial)


WELL COMPLETION DATA:
 (1) diameter (inches) 2"
 (2) total depth (feet) 420'
 (3) static water level (feet) 30' below top of ground
 (4) casing PVC 410' (material) (depth)
 2" (size) If telescope see back.
 (5) screen 10' 410' (length) (depth to top)
 2" PVC (size) (material)
 (6) pump 1/2 hp. 20 (HP) (yield gpm)
 Elec. (type power)
 (7) electric log No. (yes or no)
 (organization running log)
 (8) How well bottom plugged? Crack wash valve

DRILLERS REMARKS:

1-8-85
 ZFCW

If well telescopes please sketch and show depths.

GROUND LEVEL

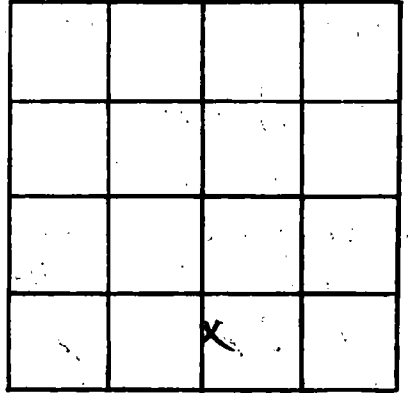

SECTION 31

Please indicate well location X.

ADDITIONAL INFORMATION

If more than one screen, show locations of each on sketch.