

MISSISSIPPI DEPARTMENT OF NATURAL RESOURCES

Bureau of Land and Water Resources

Southport Mall

P.O. Box 10631

Jackson, Mississippi 39209

WATER WELL DRILLERS LOG

CODED

JACKSON

M 238

1-28-81

1-28-81

date well completed

firm name

county well located

Coast Water Well Serv. Inc. Jackson

LANDOWNER:

Jerry Taylor

description of formations encountered

from

to

P.O. Box 327

Top soil

0

5'

Pascagoula mini. (mailing address) 39564

Red Clay

5'

8'

WELL LOCATION:

Blue Clay

8'

38'

sec. 14 T. 6 N. R. 5 E. S. W.

Red Coarse sand

38'

65'

8 miles NE of ESCATAWA (distance) (direction) (nearest town)

Blue Clay

65'

175'

WELL PURPOSE:

Home

(home, irrigation, municipal, industrial)

gray fine sand

175'

215'

WELL COMPLETION DATA:

Blue Clay

215'

260'

- (1) diameter (inches) 2"
- (2) total depth (feet) 314'
- (3) static water level (feet) 7' below top of ground.

Gray Coarse sand

260'

314'

- (4) casing PUC 304' (material) (depth)

2" (size) If telescope see back.

- (5) screen 10' 304' (length) (depth to top)

2" (size) PUC (material)

- (6) pump 1/2 hp. 30 gpm. (HP) (yield gpm)

Elect (type power)

- (7) electric log Yes (yes or no)

(organization running log)

- (8) how well bottom plugged Back wash Valve

DRILLERS REMARKS:


DEPT. OF NATURAL RESOURCES
BUREAU OF LAND & WATER RESOURCES

APR - 6 1981

RECEIVED

If well telescopes please
sketch and show depths.

GROUND LEVEL

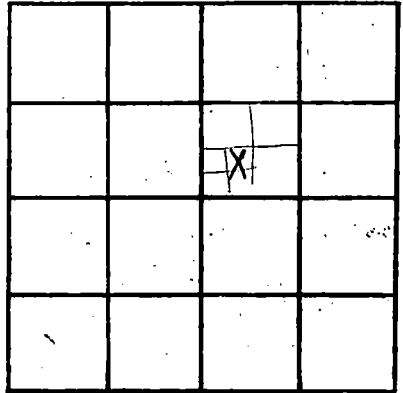

SECTION 14

Please indicate well location X.

ADDITIONAL INFORMATION

If more than one screen,
show locations of each on sketch.