

MISSISSIPPI DEPARTMENT OF NATURAL RESOURCES
Bureau of Land and Water Resources
 Southport Mall
 P.O. Box 10631
 Jackson, Mississippi 39209
WATER WELL DRILLERS LOG

CODED

Jackson
 M 240

9-18-84 date well completed 84 Coast Water Well Serv. firm name Jackson county well located

LANDOWNER: *Long Winter*
 11701 Osmond Rd.
 Pascagoula, Miss.
 (mailing address) 39564

description of formations encountered	from	to
<i>Red Clay</i>	<i>0</i>	<i>10'</i>
<i>Coarse white sand</i>	<i>10'</i>	<i>40'</i>
<i>Blue Clay</i>	<i>40'</i>	<i>78'</i>
<i>Gray Coarse sand</i>	<i>78'</i>	<i>112'</i>
<i>Gray Clay</i>	<i>112'</i>	<i>142'</i>
<i>Med. Coarse sand</i>	<i>142'</i>	<i>175'</i>

WELL LOCATION:
 sec. *19* T. *6* N. R. *4* E
S *W*
5 miles *East* of *Helena*
 (distance) (direction) (nearest town)

WELL PURPOSE: *Home*
 (home, irrigation, municipal, industrial)

- WELL COMPLETION DATA:
- (1) diameter (inches) *2"*
 - (2) total depth (feet) *175'*
 - (3) static water level (feet) *flow* below above-top of ground.
 - (4) casing *PVC* *165'*
 (material) (depth)
2"
 (size) If telescope see back.
 - (5) screen *10'* *165'*
 (length) (depth to top)
2" *PVC*
 (size) (material)
 - (6) pump _____
 (HP) (yield gpm)

 (type power)
 - (7) electric log *No*
 (yes or no)

 (organization running log)
 - (8) how well bottom plugged
Back Wash Valve

(5" x 2" Tail Pipe)

DEPT. OF NATURAL RESOURCES
 BUREAU OF LAND & WATER RESOURCES


OCT 12 1984

RECEIVED

DRILLERS REMARKS:

If well telescopes please sketch and show depths.

GROUND LEVEL

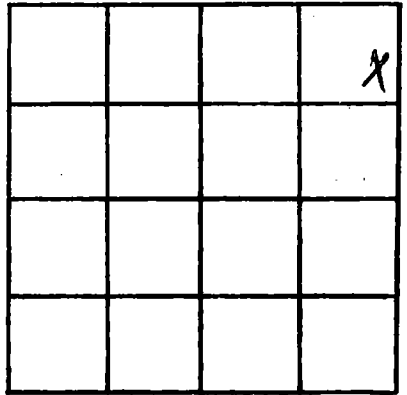

SECTION 19

Please indicate well location X.

ADDITIONAL INFORMATION

If more than one screen,
show locations of each on sketch.