

MISSISSIPPI DEPARTMENT OF NATURAL RESOURCES
Bureau of Land and Water Resources
 Southport Mall
 P.O. Box 10631 **CODED**
 Jackson, Mississippi 39209
WATER WELL DRILLERS LOG

241
M-520
JACKSON
1-15-85

1-15-85 19 Coast Water Well Sew. Jackson
 date well completed firm name county well located

Franklin Oak Baptist
 LANDOWNER: Mississippi

11601 Augustine Rd.
Mercozouly Miss.
 (mailing address) 39127

WELL LOCATION:
 sec. 31 T. 6 S. R. 4 E.
5 miles SE of Helena
 (distance) (direction) (nearest town)

WELL PURPOSE:
 (home, irrigation, municipal, industrial)

WELL COMPLETION DATA:

- (1) diameter (inches) 2"
- (2) total depth (feet) 355'
- (3) static water level (feet) Flowing below top of ground. above
- (4) casing PVC 345'
 (material) (depth)
- 2" if telescope see back.
 (size)
- (5) screen 10 345'
 (length) (depth to top)
- 2" PVC
 (size) (material)
- (6) pump — (HP) — (yield gpm)
— (type power)
- (7) electric log No
 (yes or no)
- (organization running log)
- (8) how well bottom plugged Back Wash Valve


description of formations encountered	from	to
Top soil	0	2
Gray Clay	2' 12"	
S Sand	12' 27"	
Gray Clay	27' 53"	
C. Sand	53' 70"	
Blue Clay	70' 110"	
C. Sand	110' 157"	
Blue Clay	157' 300"	
Coarse sand	300' 320"	
Blue Clay	320' 320"	
Med. Sand	320' 355"	
<u>(5' - 2" Tail Pipe)</u>		

RECEIVED
 APR 2 - 1985

DRILLERS REMARKS:

If well telescopes please sketch and show depths.

GROUND LEVEL

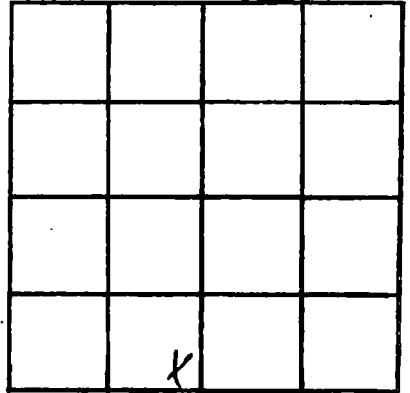

SECTION 31

Please indicate well location X.

ADDITIONAL INFORMATION

If more than one screen,
show locations of each on sketch.