

MISSISSIPPI DEPARTMENT OF NATURAL RESOURCES

Bureau of Land and Water Resources

Southport Mall

P.O. Box 10631

Jackson, Mississippi 39209 CODED

WATER WELL DRILLERS LOG

*Griner Drilling Service, Inc.*

*Jackson*

M 242  
JACKSON  
4-15-85

4-15-85 date well completed

Griner Drilling Service, Inc. firm name

Jackson county well located

LANDOWNER:  
*St. Joseph Petroleum, Inc.*  
*260 West Main*  
*Henderson, Tennessee*  
(mailing address) *37075*

description of formations encountered

from

to

*streaked*

*0 42*

*SAND*

*42 84*

*streaked*

*84 105*

CODED

WELL LOCATION: *1087' N + 990' E*

sec. *29* T. *6* N. R. *4* E of

*Dr. Mac J. Roberts* *Pascagoula*  
(direction) (nearest town)

WELL PURPOSE: *diff. supply*  
(home, irrigation, municipal, industrial)

WELL COMPLETION DATA:

(1) diameter (inches) *4"*

(2) total depth (feet) *105'*

(3) static water level (feet) *50'* <sup>below</sup> <sub>above</sub> top of ground.

(4) casing *PVC* *84'*  
(material) (depth)

*4"*  
(size) if telescope see back.

(5) screen *20'* *64'*  
(length) (depth to top)

*4"* *perforated*  
(size) (material)

(6) pump *-* *70-80*  
(HP) (yield gpm)

*AC*  
(type power)

(7) electric log  (yes or no)

(organization running log)

(8) how well bottom plugged *orange*  
*peel*


DRILLERS REMARKS:

RECEIVED  
APR 18 1985

Department of Natural Resources  
Bureau of Land & Water Resources

If well telescopes please sketch and show depths.

GROUND LEVEL

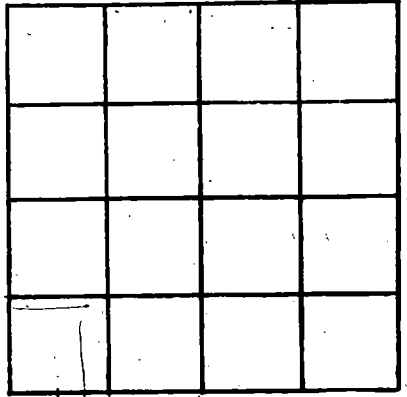

SECTION \_\_\_\_\_

Please indicate well location X.

ADDITIONAL INFORMATION

If more than one screen,  
show locations of each on sketch.