

MISSISSIPPI DEPARTMENT OF NATURAL RESOURCES

Bureau of Land and Water Resources

Southport Mall

P.O. Box 10631

Jackson, Mississippi 39209

WATER WELL DRILLERS LOG

CODED

JACKSON
M243

5-13-85 19 Coastal Water Well Saw Jackson
date well completed firm name county well located

LANDOWNER: Eric Poole
12404 Demorey Rd.
Pasadena, Miss.
(mailing address) 39567

WELL LOCATION:
sec. 32 T. 6 N. R. 4 E.
6 miles SE of Atena
(distance) (direction) (nearest town)

WELL PURPOSE: home
(home, irrigation, municipal, industrial)

- WELL COMPLETION DATA:
- (1) diameter (inches) 2"
 - (2) total depth (feet) 405'
 - (3) static water level (feet) Flowing below
top of ground. above
 - (4) casing PVC 385'
(material) (depth)
2" if telescope see back.
(size)
 - (5) screen 20' 385'
(length) (depth to top)
2" PVC
(size) (material)
 - (6) pump _____
(HP) (yield gpm)
(type power)
 - (7) electric log no
(yes or no)
(organization running log)
 - (8) how well bottom plugged Backward valve

description of formations encountered	from	to
<u>Top soil</u>	<u>0</u>	<u>4'</u>
<u>Sand</u>	<u>4'</u>	<u>35'</u>
<u>Blue Clay</u>	<u>35'</u>	<u>85'</u>
<u>Sand</u>	<u>85'</u>	<u>115'</u>
<u>Sand & Sea Shell</u>	<u>115'</u>	<u>160'</u>
<u>Blue Clay</u>	<u>160'</u>	<u>190'</u>
<u>Sand</u>	<u>190'</u>	<u>220'</u>
<u>Blue Clay</u>	<u>220'</u>	<u>310'</u>
<u>Coarse River Sand</u>	<u>310'</u>	<u>405'</u>
<u>5' Tail Pipe</u>		

CODED


RECEIVED
JUL 10 1985

Department of Natural Resources
Bureau of Land & Water Resources

DRILLERS REMARKS:

If well telescopes please sketch and show depths.

GROUND LEVEL

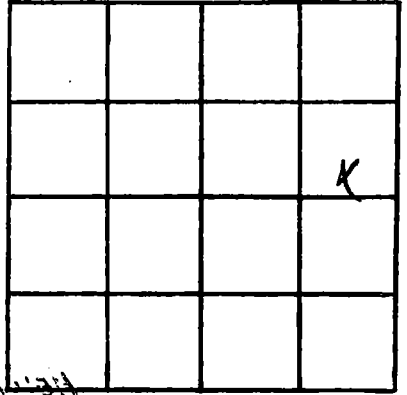

SECTION 32

Please indicate well location X.

ADDITIONAL INFORMATION

Lined area for additional information.

If more than one screen, show locations of each on sketch.