

MISSISSIPPI DEPARTMENT OF NATURAL RESOURCES

Bureau of Land and Water Resources

Southport Mall

P.O. Box 10631

Jackson, Mississippi 39209

WATER WELL DRILLERS LOG

CODED

Jackson
M 248

10-2-85 19 Coastwater Well Jackson
date well completed firm name county well located

LANDOWNER: Wadey Stark

description of formations encountered

from to

Pascagoula Miss.
(mailing address) 39527

Top Sand 0' 5'
White Coarse Sand 5' 30'

WELL LOCATION:

sec. 31 T. 6 S R. 4 W
5 miles NE of ESCATAWA
(distance) (direction) (nearest town)

Red Gravel 30' 45'
Blue Clay 45' 55'

WELL PURPOSE: Home
(home, irrigation, municipal, industrial)

Gray Coarse Sand 55' 75'
Blue Clay 75' 120'

WELL COMPLETION DATA:

- (1) diameter (inches) 2"
- (2) total depth (feet) 380'
- (3) static water level (feet) Flow below above top of ground.
- (4) casing PVC 355'
(material) (depth)
2"
(size) If telescope see back.
- (5) screen 20' 355'
(length) (depth to top)
2" PVC
(size) (material)
- (6) pump _____
(HP) (yield gpm)
- (type power) _____
- (7) electric log no
(yes or no)
- (organization running log) _____
- (8) how well bottom plugged Backwash valve

Gray Coarse Sand 120' 147'
Blue Clay 147' 240'
Gray Fine Sand 240' 250'
Blue Clay 250' 330'
Gray Coarse Sand 330' 380'

CODED

RECEIVED

NOV 26 1985


Department of Natural Resources
Bureau of Land & Water Resources

DRILLERS REMARKS:

5 2" tail pipe

If well telescopes please sketch and show depths.

GROUND LEVEL

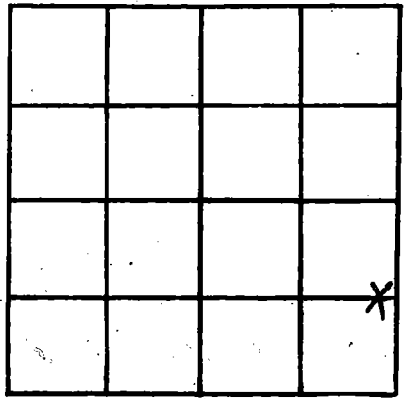

SECTION 31

Please indicate well location X.

ADDITIONAL INFORMATION

If more than one screen, show locations of each on sketch.