

MISSISSIPPI DEPARTMENT OF NATURAL RESOURCES

Bureau of Land and Water Resources

Southport Mall

P.O. Box 10631

Jackson, Mississippi 39209

WATER WELL DRILLERS LOG

Jackson  
M249

CODED

4-14-19 date well completed

firm name

county well located

Sp Price Drilling Co. Jackson

LANDOWNER:

Maurice Jurby

description of formations encountered

from

to

Nut bank Rd.

top soil

0

10

Poseyville ms (mailing address)

Clay

10

20

Sand

20

25

WELL LOCATION:

Clay

35

150

sec. 23 T. 4 N R. 5 E

good sand

150

170

5 miles South of Big Point (distance) (direction) (nearest town)

WELL PURPOSE:

(home, irrigation, municipal, industrial)

WELL COMPLETION DATA:

(1) diameter (inches) 4"

(2) total depth (feet) 170'

(3) static water level (feet) 20' below top of ground.

(4) casing plastic, 1100' (material) (depth)

0 (size) If telescope see back.

(5) screen 10', 170' (length) (depth to top)

006, plastic (size) (material)

(6) pump 3 (HP), 60 (yield gpm)

electric (type power)

(7) electric log (yes or no)

(organization running log)

(8) how well bottom plugged BU

DRILLERS REMARKS:


CODED

RECEIVED  
MAY 14 1986

Department of Natural Resources  
Bureau of Land & Water Resources

If well telescopes please  
sketch and show depths.

GROUND LEVEL

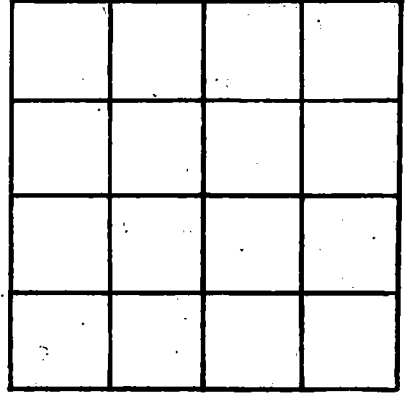

SECTION \_\_\_\_\_

Please indicate well location X:

ADDITIONAL INFORMATION

If more than one screen,  
show locations of each on sketch.