

**MISSISSIPPI DEPARTMENT OF NATURAL RESOURCES**

Bureau of Land and Water Resources

COUNTY WELL LOCATED <b>Jackson</b>	
WELL NUMBER <b>M 251</b>	CODED
DATE WELL COMPLETED <b>10-30-86</b>	

PERMIT NUMBER
NAME OF DRILLING FIRM <b>Coast water well</b>

P.O. Box 10631  
Jackson, Mississippi 39209  
**WATER WELL DRILLERS LOG**

NAME & MAILING ADDRESS OF LANDOWNER <b>Randy Christian</b>		
<b>11813 Chatsworth</b>		
<b>Pascagoula MS</b>		
WELL LOCATION: <small>S</small>	TOWNSHIP <small>N</small>	RANGE <small>E</small>
<b>20</b>	<b>6</b>	<b>4</b>
DISTANCE <b>1.0</b> Miles	DIRECTION <b>NE</b>	NEAREST TOWN <b>Mass Point</b>
OTHER LANDMARK		
WELL PURPOSE: Home, Irrigation, Municipal, Industrial, Fish Pond, etc. <b>home</b>		

<b>PUMP DATA</b>		
PUMP TYPE (Circle One): Submersible, Turbine, <b>Jet</b> Flowing Well, Other (Describe) _____		
POWER TYPE (Circle One): <b>Electric</b> , Tractor, Diesel, Gasoline, Butane, Other (Describe) _____		
Pump Capacity (GPM) <b>15</b>	No. of Stages <b>1</b>	Setting Depth <b>FT.</b>
PUMP TEST Well yielded _____ GPM with a drawdown of _____ ft. after _____ hours of pumping		

<b>WELL DATA</b>		
Well Depth <b>342'</b>	Casing Diameter (In.) <b>2"</b>	Casing Length (Ft.) <b>317'</b>
Type of Casing <b>PVC</b>	Hole Depth <b>342'</b>	Depth to Static Water Level <b>flow</b>
TYPE OF COMPLETION: (Circle One or More): <b>Gravel Packed</b> , Underreamed, Telescoped, <b>Natural Development</b> , Open Hole, Other (Describe) _____		
Top of Lap Pipe or Reduction in Casing <b>FEET</b> IF TELESCOPED OR MORE THAN ONE SCREEN: USE BACK PAGE		

<b>LOG DATA</b>	
TYPE OF LOG RUN (Circle One): Electric, Gamma Ray, Density, Sonic, <b>No Log Run</b> , Neutron, Other (Describe) _____	
Name of Organization Running Log	

<b>SCREEN DATA</b>		
Diameter - Inches <b>2"</b>	Length - Feet <b>20'</b>	Slot Size - Inches <b>.008</b>
Screen Type <b>PVC</b>	Depth to Bottom - Feet <b>337'</b>	

<b>GEOLOGIC DATA (Office Use Only)</b>			
Surface Elev.	Geologic Unit	Unit Thickness	Depth to Top
Subs. SWL	Date	Analysis	Aquifer Test

Driller's Remarks

**RECEIVED**

DESCRIPTION OF FORMATIONS ENCOUNTERED	FROM	TO	FORMATIONS (Continued)	FROM	TO
Top Soil	0	2			
Red Med Sand	2	20			
Red Coarse Sand	20	31			
Red Coarse Sand + Gravel	31	41			
Blue Clay	41	70			
White Coarse Sand	70	114			
Blue Clay	114	210			
Gray Coarse Sand	210	337			
Gray Coarse Sand	337	342			
Wood Gravel					


NOV 24 1986

Department of Natural Resources  
Bureau of Land & Water Resources

IF MORE SPACE IS NEEDED, USE BACK

If well telescopes please sketch and show depths.

GROUND LEVEL

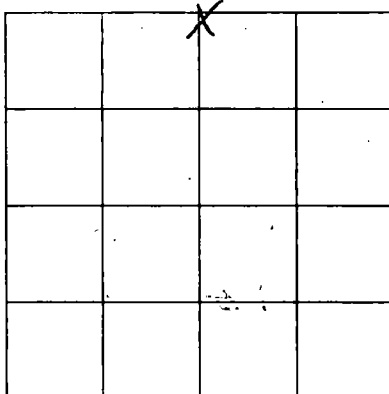

SECTION 20

Please indicate well location X.

**ADDITIONAL INFORMATION**

If more than one screen,  
show location of each on sketch.