

MISSISSIPPI DEPARTMENT OF NATURAL RESOURCES
 Bureau of Land and Water Resources
 Southport Mall
 P.O. Box 10631
 Jackson, Mississippi 39209
WATER WELL DRILLERS LOG

CODED

JACKSON
 M 253

12-12-19 86 Pierce Drilling Co. Jackson Co.
 date well completed firm name county well located

LANDOWNER: Pete Turley
Helena
Pascagoula, M.S.
 (mailing address)

description of formations encountered	from	to
<u>top soil</u>	<u>0</u>	<u>10</u>
<u>Clay</u>	<u>10</u>	<u>20</u>
<u>Sand</u>	<u>20</u>	<u>125</u>
<u>Clay</u>	<u>125</u>	<u>175</u>
<u>good sand</u>	<u>175</u>	<u>212</u>

WELL LOCATION:
 sec. 9 T 6 N R 5 E
4 miles South of Big Point
 (distance) (direction) (nearest town)

WELL PURPOSE:
 (home, irrigation, municipal, industrial)

WELL COMPLETION DATA:

(1) diameter (inches) 4"

(2) total depth (feet) 212'

(3) static water level (feet) 12' ^{below} _{above} top of ground.

(4) casing plastic, 182'
 (material) (depth)

0 if telescope see back.
 (size)

(5) screen 30', 212'
 (length) (depth to top)

006, plastic
 (size) (material)

(6) pump 3 85
 (HP) (yield gpm)

electric
 (type power)

(7) electric log yes or no
 (organization running log)

(8) how well bottom plugged BW

CODED




SEP 15 1987

Department of Natural Resources
 Bureau of Land & Water Resources

DRILLERS REMARKS:

If well telescopes please sketch and show depths.

GROUND LEVEL

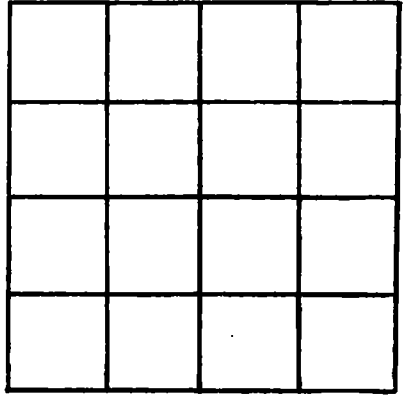

SECTION _____

Please indicate well location X.

ADDITIONAL INFORMATION

If more than one screen,
show locations of each on sketch.