

add loc. pump
MISSISSIPPI DEPARTMENT OF NATURAL RESOURCES
 Bureau of Land and Water Resources

P.O. Box 10631
 Jackson, Mississippi 39209
WATER WELL DRILLERS LOG

COUNTY WELL LOCATED <i>Jackson</i>	
WELL NUMBER <i>M257</i>	CODED <input checked="" type="checkbox"/>
DATE WELL COMPLETED <i>2-20-88</i>	

PERMIT NUMBER
NAME OF DRILLING FIRM <i>Cond water well Service</i>

NAME & MAILING ADDRESS OF LANDOWNER <i>Hollis Elder</i>			
<i>FORTS LAKE Rd</i>			
<i>PASCAGOULA, Ms</i>			
WELL LOCATION:	SEC <i>31</i>	TOWNSHIP <i>6</i>	RANGE <i>4</i>
DISTANCE <i>6</i>	DIRECTION <i>EAST</i>	NEAREST TOWN <i>Moss Point</i>	
OTHER LANDMARK			
WELL PURPOSE: Home, Irrigation, Municipal, Industrial, Fish Pond, etc. <i>home</i>			

PUMP DATA		
PUMP TYPE (Circle One): Submersible, Turbine, Jet , Flowing Well, Other (Describe) _____		
POWER TYPE (Circle One): Electric , Tractor, Diesel, Gasoline, Butane, Other (Describe) _____		
Pump Capacity (GPM) <i>15</i>	No. of Stages <i>1</i>	Setting Depth _____ FT.
PUMP TEST		
Well yielded _____ GPM with a drawdown of _____ ft. after _____ hours of pumping		


WELL DATA		
Well Depth <i>429</i>	Casing Diameter (In.) <i>2"</i>	Casing Length (Ft.) <i>414</i>
Type of Casing <i>PVC</i>	Hole Depth <i>429</i>	Depth to Static Water Level <i>flow</i>
TYPE OF COMPLETION: (Circle One or More): Gravel Packed, Underreamed, Telescoped, Natural Development , Open Hole, Other (Describe) _____		
Top of Lap Pipe or Reduction in Casing FEET _____ IF TELESCOPED OR MORE THAN ONE SCREEN: USE BACK PAGE		

LOG DATA	
TYPE OF LOG RUN (Circle One): Electric, Gamma Ray, Density, Sonic, No Log Run , Neutron, Other (Describe) _____	
Name of Organization Running Log	

SCREEN DATA		
Diameter - Inches <i>2"</i>	Length - Feet <i>10'</i>	Slot Size - Inches <i>008</i>
Screen Type <i>PVC</i>		Depth to Bottom - Feet <i>424</i>

GEOLOGIC DATA (Office Use Only)			
Surface Elev.	Geologic Unit	Unit Thickness	Depth to Top
Subs. SWL	Date	Analysis	Aquifer Test
Driller's Remarks			

DESCRIPTION OF FORMATIONS ENCOUNTERED	FROM	TO
<i>Jap Sand</i>	<i>0</i>	<i>2</i>
<i>Brown Clay</i>	<i>2</i>	<i>20</i>
<i>white coarse sand</i>	<i>20</i>	<i>40</i>
<i>Blue Clay</i>	<i>40</i>	<i>105</i>
<i>Gray coarse sand</i>	<i>105</i>	<i>152</i>
<i>Red Clay</i>	<i>152</i>	<i>320</i>
<i>fine gray sand</i>	<i>320</i>	<i>344</i>
<i>med gray sand</i>	<i>344</i>	<i>365</i>
<i>gray coarse sand</i>	<i>365</i>	<i>425</i>
<i>Blue Clay</i>	<i>425</i>	<i>429</i>

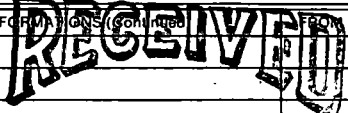


MAY 24 1988

Department of Natural Resources
 Bureau of Land & Water Resources

IF MORE SPACE IS NEEDED, USE BACK

If well telescopes please sketch and show depths.

GROUND LEVEL

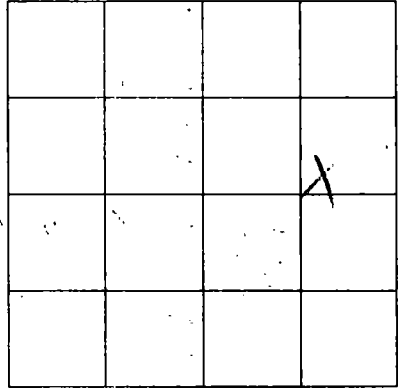

SECTION 31

Please indicate well location X.

ADDITIONAL INFORMATION

If more than one screen,
show location of each on sketch.