

MISSISSIPPI DEPARTMENT OF NATURAL RESOURCES

Bureau of Land and Water Resources

COUNTY WELL LOCATED <i>Jackson</i>		3950
WELL NUMBER <i>M 266</i>	CODED <input checked="" type="checkbox"/>	
DATE WELL COMPLETED <i>5-18-90</i>		

PERMIT NUMBER
NAME OF DRILLING FIRM <i>Coast Water Well Ser. Inc.</i>

P.O. Box 10631
Jackson, Mississippi 39209
WATER WELL DRILLERS LOG

NAME & MAILING ADDRESS OF LANDOWNER <i>Jack Logan</i>			
<i>Sarasenia Rd.</i>			
<i>Pascagoula, Ms.</i>			
WELL LOCATION: SEC	TOWNSHIP	RANGE	
<i>31</i>	<i>6</i>	<i>N</i>	<i>5</i>
		<i>S</i>	<i>W</i>
DISTANCE	DIRECTION	NEAREST TOWN	
<i>2</i> Miles	<i>NE</i>	<i>Escatawpa</i>	
OTHER LANDMARK			
WELL PURPOSE: <input checked="" type="radio"/> Home <input type="radio"/> Irrigation, Municipal, Industrial, Fish Pond, etc.			

PUMP DATA		
PUMP TYPE (Circle One): Submersible, Turbine, <input checked="" type="radio"/> Jet, Flowing Well, Other (Describe) _____		
POWER TYPE (Circle One): <input checked="" type="radio"/> Electric, Tractor, Diesel, Gasoline, Butane, Other (Describe) _____ H/P <i>Y2</i>		
Pump Capacity (GPM) <i>10</i>	No. of Stages <i>1</i>	Setting Depth FT.
PUMP TEST		
Well yielded _____ GPM with a drawdown of _____ ft. after _____ hours of pumping		

WELL DATA		
Well Depth <i>720</i>	Casing Diameter (In.) <i>2"</i>	Casing Length (Ft.) <i>695</i>
Type of Casing <i>PVC</i>	Hole Depth <i>720</i>	Depth to Static Water Level <i>6'</i>
TYPE OF COMPLETION: (Circle One or More): <input checked="" type="checkbox"/> Gravel Packed, <input type="checkbox"/> Underreamed, <input type="checkbox"/> Telescoped, <input checked="" type="checkbox"/> Natural Development, <input type="checkbox"/> Open Hole, <input type="checkbox"/> Other <input checked="" type="checkbox"/> (Describe) _____		
Top of Lap Pipe or Reduction in Casing		
FEET <input type="checkbox"/> IF TELESCOPED OR MORE THAN ONE SCREEN: USE BACK PAGE		

LOG DATA	
TYPE OF LOG RUN (Circle One): Electric, Gamma Ray, Density, Sonic, Neutron, Other (Describe) _____ <input checked="" type="radio"/> No Log Run	
Name of Organization Running Log	

SCREEN DATA		
Diameter - Inches <i>2'</i>	Length - Feet <i>20'</i>	Slot Size - Inches <i>.008</i>
Screen Type <i>PVC</i>	Depth to Bottom - Feet <i>715'</i>	


GEOLOGIC DATA (Office Use Only)			
Surface Elev.	Geologic Unit	Unit Thickness	Depth to Top
Subs. SWL	Date	Analysis	Aquifer Test
Driller's Remarks			

DESCRIPTION OF FORMATIONS ENCOUNTERED	FROM	TO
<i>Top soil</i>	<i>0</i>	<i>5</i>
<i>Yellow clay</i>	<i>5</i>	<i>18</i>
<i>Coarse sand, mud</i>	<i>18</i>	<i>75</i>
<i>Blue clay</i>	<i>75</i>	<i>205</i>
<i>Fine sand</i>	<i>205</i>	<i>230</i>
<i>Blue clay</i>	<i>230</i>	<i>295</i>
<i>Fine sand</i>	<i>295</i>	<i>301</i>
<i>Blue clay</i>	<i>301</i>	<i>410</i>
<i>Fine sand / shell</i>	<i>410</i>	<i>420</i>
<i>Blue clay / streak of sand</i>	<i>420</i>	<i>685</i>
<i>Fine to coarse sand</i>	<i>685</i>	<i>720</i>

FORMATIONS (Continued)		FROM	TO
RECEIVED			
OCT 12 1990			
Department of Natural Resources Bureau of Land & Water Resources			
IF MORE SPACE IS NEEDED, USE BACK			

If well telescopes please sketch and show depths.

GROUND LEVEL

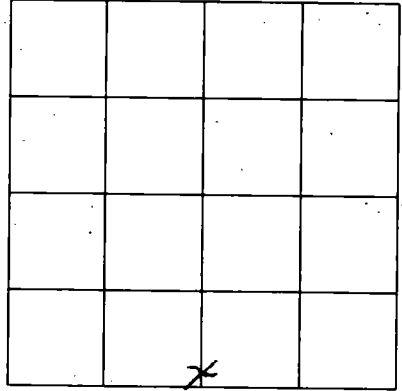

SECTION

31

Please indicate well location X.

ADDITIONAL INFORMATION

If more than one screen,
show location of each on sketch.