

MISSISSIPPI DEPARTMENT OF ENVIRONMENTAL QUALITY

Office of Land and Water Resources

P. O. Box 10631
Jackson, MS 39289-0631
WATER WELL DRILLERS LOG

COUNTY WELL LOCATED JACKSON	
WELL NUMBER M 273	CODED <input checked="" type="checkbox"/>
DATE WELL COMPLETED 12-1-92	

PERMIT NUMBER
NAME OF DRILLING FIRM Coast Water Well

NAME & MAILING ADDRESS OF LANDOWNER Kevin Sewelling			
WELL LOCATION: SEC <u>3</u> TOWNSHIP <u>6</u> RANGE <u>5</u> ^N _E ^W			
DISTANCE <u>2</u> Miles		DIRECTION <u>S</u> of NEAREST TOWN <u>Big Point</u>	
OTHER LANDMARK			
WELL PURPOSE: <u>Home</u> , Irrigation, Municipal, Industrial, Fish Pond, etc.			

PUMP DATA		
PUMP TYPE (Circle One): Submersible, Turbine, <u>Jet</u> Flowing Well, Other (Describe) _____		
POWER TYPE (Circle One): <u>Electric</u> , Tractor, Diesel, Gasoline, Butane, Other (Describe) _____ H/P <u>1</u>		
Pump Capacity (GPM) <u>12</u>	No. of Stages <u>2</u>	Setting Depth _____ FT.
PUMP TEST		
Well yielded _____ GPM with a drawdown of _____ ft. after _____ hours of pumping		

WELL DATA		
Well Depth <u>64</u>	Casing Diameter (In.) <u>2"</u>	Casing Length (Ft.) <u>58</u>
Type of Casing <u>PVC</u>	Hole Depth <u>64</u>	Depth to Static Water Level <u>10'</u>

LOG DATA	
TYPE OF LOG RUN (Circle One): Electric, Gamma Ray, Density, Sonic, Neutron, Other (Describe) _____ <u>No Log Run</u>	
Name of Organization Running Log	

TYPE OF COMPLETION: (Circle One or More): <u>Natural Development</u> , Gravel Packed, Underreamed, Telescoped, Open Hole, Other			
WELL GROUTED TO A DEPTH OF <u>10</u> FEET Type Grout (circle one): Cement, Bentonite, or Mix			

GEOLOGIC DATA (Office Use Only)			
Surface Elev.	Geologic Unit	Unit Thickness	Depth to Top
Subs. SWL	Date	Analysis	Aquifer Test

SCREEN DATA		
Diameter - Inches <u>2"</u>	Length - Feet <u>6'</u>	Slot Size - Inches <u>8</u>
Screen Type <u>PVC</u>	Depth to Bottom - Feet <u>64</u>	


Driller's Remarks		

DESCRIPTION OF FORMATIONS ENCOUNTERED	FROM	TO
<u>top soil</u>	<u>0</u>	<u>2</u>
<u>Red Clay</u>	<u>2</u>	<u>26</u>
<u>Coarse Sand & Blak</u>	<u>2</u>	<u>64</u>

FORMATIONS (Continued)	FROM	TO
RECEIVED		
JAN 27 1993		
Dept. of Environmental Quality Office of Land & Water Resources		
IF MORE SPACE IS NEEDED, USE BACK		

If well telescopes please sketch and show depths.

GROUND LEVEL

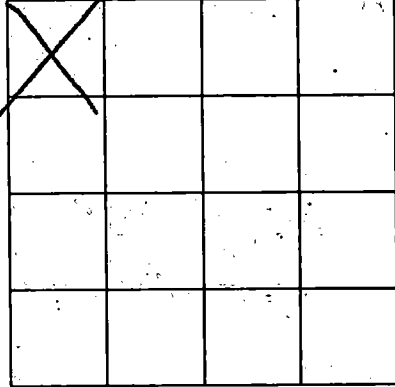

SECTION _____

Please indicate well location X.

ADDITIONAL INFORMATION

Lined area for additional information, consisting of approximately 20 horizontal lines.

STATE OF NEW YORK
DEPARTMENT OF ENVIRONMENTAL CONSERVATION

WATER RESOURCES DIVISION

If more than one screen, show location of each on sketch.