

JACKSON  
 M 342  
 9-30-74

MISSISSIPPI  
 BOARD OF WATER COMMISSIONERS  
 416 North State Street  
 Jackson, Mississippi 39201

CODED

WATER WELL DRILLERS LOG

April 30 1974 Colville Water Sys Jackson  
 date well completed firm name county well located


LANDOWNER: R. W.  
O wens  
Big Point, Ms.  
 (mailing address)  
 WELL LOCATION:  
 sec. 3 T. 6 N. R. 5 E. W. W  
11 miles N. of M.P.  
 (distance) (direction) (nearest town)

| description of formations encountered | from      | to        |
|---------------------------------------|-----------|-----------|
| <u>clay</u>                           | <u>0</u>  | <u>16</u> |
| <u>sand</u>                           | <u>16</u> | <u>70</u> |
| <u>clay</u>                           | <u>70</u> | <u>47</u> |
| <u>sand</u>                           | <u>47</u> | <u>57</u> |

WELL PURPOSE: home  
 (home, irrigation, municipal, industrial)

WELL COMPLETION DATA:  
 (1) diameter (inches) 2  
 (2) total depth (feet) 515  
 (3) static water level (feet) 4 below above top of ground.  
 (4) casing: plastic 505  
 (material) (depth)  
 (size) If telescope see back.  
 (5) screen 10 505  
 (length) (depth to top)  
2 plastic SS.  
 (size) (material)  
 (6) pump 1/2 17  
 (HP) (yield gpm)  
dec  
 (type power)  
 (7) electric log no  
 (yes or no)  
 (organization running log)  
 (8) how well bottom plugged B.P. Value

CODED

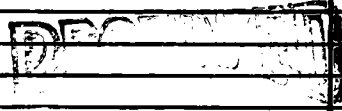


SEP 30 1974

DRILLERS REMARKS:

BOARD OF WATER COMMISSIONERS

If well telescopes please sketch and show depths.

GROUND LEVEL

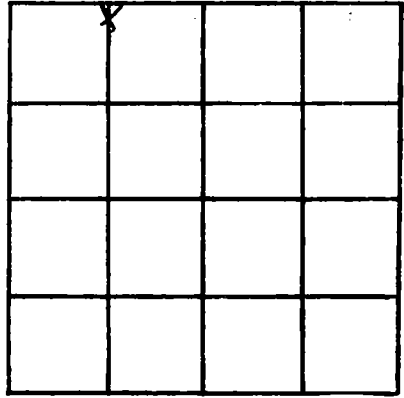

SECTION 3

Please indicate well location X.

ADDITIONAL INFORMATION

If more than one screen, show locations of each on sketch.