

MISSISSIPPI DEPARTMENT OF ENVIRONMENTAL QUALITY

Office of Land and Water Resources

P. O. Box 10631  
Jackson, MS 39289-0631  
WATER WELL DRILLERS LOG

COUNTY WELL LOCATED  
Jackson

WELL NUMBER M 347 CODED

DATE WELL COMPLETED  
9-28-94

PERMIT NUMBER

NAME OF DRILLING FIRM  
Pierci

NAME & MAILING ADDRESS OF LANDOWNER  
Eddie Inammell  
Wolf Ridge Rd.  
Pascagoula, MS

WELL LOCATION SEC 7 TOWNSHIP 6 RANGE 5 N S E W

DISTANCE 4 Miles DIRECTION S of NEAREST TOWN Big Point

OTHER LANDMARK NESW NE

WELL PURPOSE:  Home Irrigation,  Municipal,  Industrial,  Fish Pond, etc.

PUMP DATA

PUMP TYPE (Circle One):  
Submersible, Turbine,  Jet,  Flowing Well, Other (Describe) \_\_\_\_\_

POWER TYPE (Circle One):  
 Electric,  Tractor,  Diesel,  Gasoline,  Butane, Other (Describe) \_\_\_\_\_ H/P 1

Pump Capacity (GPM) 10 No. of Stages 2 Setting Depth 60 FT.

PUMP TEST

Well yielded 10 GPM with a drawdown of 10 ft. after 1 hours of pumping

WELL DATA

Well Depth 190' Casing Diameter (In.) 2" Casing Length (Ft.) 180'

Type of Casing Plastic Hole Depth 190' Depth to Static Water Level 30'

TYPE OF COMPLETION: (Circle One or More):  
 Gravel Packed,  Underreamed,  Telescoped,  Natural Development,  Open Hole,  Other (Describe) \_\_\_\_\_

WELL GROUTED TO A DEPTH OF 15 FEET  
Type Grout (circle one): Cement, Bentonite,  Mix

LOG DATA

TYPE OF LOG RUN (Circle One):  
Electric, Gamma Ray, Density, Sonic, Neutron, Other (Describe) \_\_\_\_\_  No Log Run.

Name of Organization Running Log \_\_\_\_\_

SCREEN DATA

Diameter - Inches 2" Length - Feet 10' Slot Size - Inches 004

Screen Type Plastic Depth to Bottom - Feet 190

GEOLOGIC DATA (Office Use Only)

Surface Elev.	Geologic Unit	Unit Thickness	Depth to Top
Subs SWL	Date	Analysis	Aquifer Test

Driller's Remarks

Top of Lap Pipe or Reduction in Casing

FEET  IF TELESCOPED OR MORE THAN ONE SCREEN: USE BACK PAGE

DESCRIPTION OF FORMATIONS ENCOUNTERED	FROM	TO
<u>Top Soil</u>	<u>0</u>	<u>10</u>
<u>Clay</u>	<u>10</u>	<u>20</u>
<u>Sand</u>	<u>20</u>	<u>120</u>
<u>Clay</u>	<u>120</u>	<u>140</u>
<u>Sand + Clay</u>	<u>140</u>	<u>170</u>
<u>good Sand</u>	<u>170</u>	<u>190</u>

FORMATIONS ENCOUNTERED TO

**RECEIVED**


**JAN 11 1995**

Dept. of Environmental Quality  
Office of Land & Water Resources

IF MORE SPACE IS NEEDED, USE BACK

If well telescopes please sketch and show depths.

GROUND LEVEL

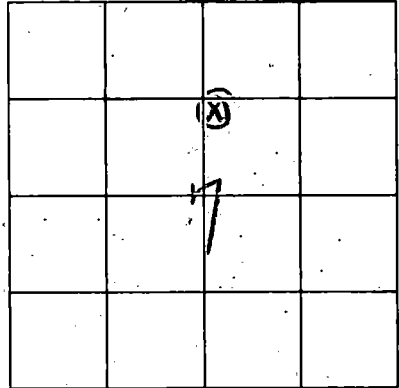

SECTION \_\_\_\_\_

Please indicate well location X.

ADDITIONAL INFORMATION

Multiple horizontal lines for additional information.

RESERVED

JUL 1 1952

Office of Water Resources  
U.S. Geological Survey

If more than one screen, show location of each on sketch.