

MISSISSIPPI DEPARTMENT OF ENVIRONMENTAL QUALITY

Office of Land and Water Resources

P. O. Box 10631

Jackson, MS 39289-0631

WATER WELL DRILLERS LOG

COUNTY WELL LOCATED <b>Jackson</b>	
WELL NUMBER <b>M-411</b>	CODED
DATE WELL COMPLETED <b>7-21-04</b>	

PERMIT NUMBER
NAME OF DRILLING FIRM <b>Coast Water Well Service</b>

NAME & MAILING ADDRESS OF LANDOWNER <b>Richard Jones</b>			
<b>14120 Hwy 613</b>			
Latitude:			
Longitude: <b>Miss Point, MS</b>			
WELL LOCATION	SEC	TOWNSHIP	RANGE
	<b>4</b>	<b>6<sup>th</sup></b>	<b>5<sup>th</sup></b>
DISTANCE	DIRECTION	NEAREST TOWN	
<b>3</b> Miles	<b>SOUTH</b>	of <b>B.9 Point</b>	
OTHER LANDMARK			
WELL PURPOSE: <input checked="" type="checkbox"/> Home, <input type="checkbox"/> Irrigation, <input type="checkbox"/> Municipal, <input type="checkbox"/> Industrial, <input type="checkbox"/> Fish Pond, etc.			

PUMP DATA

PUMP TYPE (Circle One):	Submersible, Turbine, <input checked="" type="checkbox"/> <b>Jet</b> , <input type="checkbox"/> Flowing Well,
Other (Describe) _____	
POWER TYPE (Circle One):	<input checked="" type="checkbox"/> Electric, <input type="checkbox"/> Tractor, <input type="checkbox"/> Diesel, <input type="checkbox"/> Gasoline, <input type="checkbox"/> Butane,
Other (Describe) _____ H/P <input checked="" type="checkbox"/> _____	

DESCRIPTION OF FORMATIONS ENCOUNTERED	FROM	TO
<b>TOP SOIL</b>	<b>0</b>	<b>1</b>
<b>Orange-White Clay</b>	<b>1</b>	<b>25</b>
<b>White Coarse Sand</b>	<b>25</b>	<b>72</b>
<b>Blue Clay</b>	<b>72</b>	<b>132</b>
<b>Grey Coarse Sand</b>	<b>132</b>	<b>173</b>

WELL DATA

Well Depth <b>173'</b>	Casing Diameter (In.) <b>2"</b>	Casing Length (Ft.) <b>163'</b>
Type of Casing <b>PVC</b>	Hole Depth <b>173'</b>	Depth to Static Water Level <b>15'</b>
TYPE OF COMPLETION: (Circle One or More):		
<input checked="" type="checkbox"/> Gravel Packed, <input type="checkbox"/> Underreamed, <input type="checkbox"/> Telescoped, <input checked="" type="checkbox"/> Natural Development, <input type="checkbox"/> Open Hole, <input type="checkbox"/> Other (Describe) _____		
WELL GROUTED TO A DEPTH OF <b>10</b> FEET		
Type Grout (circle one): <input type="checkbox"/> Cement, <input checked="" type="checkbox"/> Bentonite, or <input type="checkbox"/> Mix		

SCREEN DATA

Diameter - Inches <b>2"</b>	Length - Feet <b>10'</b>	Slot Size - Inches <b>.006</b>
Screen Type <b>PVC</b>	Depth to Bottom - Feet <b>173'</b>	

**RECEIVED**

**AUG 04 2004**

**BY: OLWR**


Top of Lap Pipe or Reduction in Casing	FEET	IF TELESCOPED OR MORE THAN ONE SCREEN: USE BACK PAGE

I certify that the well was drilled, constructed and completed in accordance with all applicable Requirements of the Mississippi Department of Environmental Quality and/or the Mississippi Department of Health regulations and state laws.

Signature of Licensed Driller and License No. **John Pridgett 472**      Date **7/31/04**

If well telescopes please sketch and show depths.

GROUND LEVEL

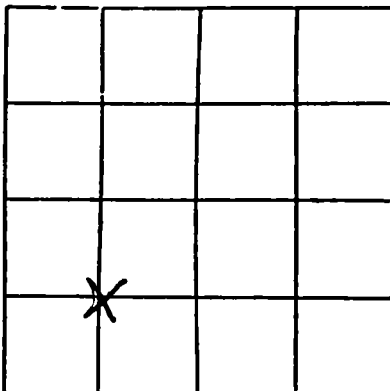

SECTION 4

Please indicate well location X.

Pump Capacity (GPM) <u>9</u>	No. of Stages <u>2</u>	Setting Depth _____ FT.
PUMP TEST		
Well yielded _____ GPM with a drawdown of _____ ft. after _____ hours of pumping		

LOG DATA

TYPE OF LOG RUN (Circle One): Electric, Gamma Ray, Density, Sonic, Neutron, Other (Describe) _____	<u>No Log Run</u>
Name of Organization Running Log _____	

GEOLOGIC DATA (Office Use Only)

Surface Elev.	Geologic Unit	Unit Thickness	Depth to Top
Subs. SWL	Date	Analysis	Aquifer Test

Driller's Remarks

If more than one screen, show location of each on sketch.