

State Well Report

Part 1

Mississippi Department of Environmental Quality
Office of Land and Water Resources
P.O. Box 10631
Jackson, MS 39289-0631
(601)961-5210
(601)354-6938 (fax)

For Office Use Only:

Aquifer: _____
Well #: M-422
L. S. Elevation: _____
E-log #: _____

County: Jackson 059
Permit #: _____
Driller: Coast Water Wellsrv
Date drilling completed: 1-4-05

State Law requires that this report be prepared by the driller in detail and filed with the Department within 30 days of completion of drilling of the well.

Well Owner Information	Well Location
Owner Name <u>John + Cindy Ishee</u>	Latitude: <u>30° 29' 78"</u> Longitude: <u>088° 41' 826"</u>
Mailing Address: <u>9600 Lyons Lake Rd</u>	Method of Lat/Long (circle one): Conventional Survey, <u>30 42 27 08</u>
<u>MOSS POINT MS 39562</u>	USGS quad, <u>Hand-held GPS</u> Survey-grade GPS
City State Zip Code	<u>SW 1/4 NE 1/4 Sec 23 Twn 765 Rng R5W</u>
Telephone No. <u>(228) 475-0417</u>	Distance Direction Nearest Town <u>3</u> Miles <u>EAST</u> of <u>HELENA</u>

Well Data

Purpose of Well (circle one) Home Industrial Public Supply Irrigation Fish Culture Other: _____

Date well drilling started: 1-4-05 Date well drilling completed: 1-4-05

If flowing, method of flow regulation: Valve N/A Other (describe) _____

Static Water Level: 10 feet above or below (circle one) land surface Date measured: 1-4-05

Method of Measurement (circle one) steel tape electric tape air line other: _____

Hole depth: 231' Well depth: 231' Well grouted to a depth of 10 feet

Type of grout (circle one): Cement Bentonite Mix

Casing length: 221 feet Casing diameter: 2 inches Type of casing: PVC

Screen length: 10 feet Screen diameter: 2 inches Type of screen: PVC

Screen slot size: .004 inches Setting depth: From 221 feet to 231 feet

Type of completion (circle all applicable): Gravel packed Underreamed Telescoped Open hole Natural Development

Other (describe): _____

Top of lap pipe or reduction in casing: N/A feet. If telescoped or more than one screen, describe on back of page

Logs run (circle all applicable) No log run Electric Gamma Ray Density Sonic Neutron Other: _____


Name of organization running log(s): N/A

I certify that the well was drilled, constructed, and completed in accordance with all applicable requirements of the Mississippi Department of Environmental Quality and/or the Mississippi Department of Health regulations and state laws.

Jack Ridgdell 0-472
Print Name of Water Well Contractor and License No.


Jack Ridgdell
Signature of Water Well Contractor


If well telescopes please sketch below and show depths.

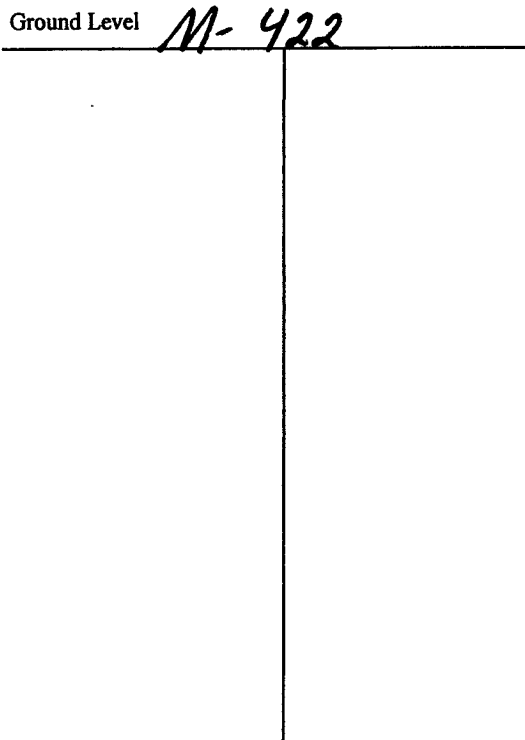

Description of Formations Encountered	From	To
Top Soil	0	2
Orange Clay	2	18
White Coarse Sand	18	50
Blue Clay	50	205
Gray Medium Sand	205	331

If more than one screen, show location of each on sketch

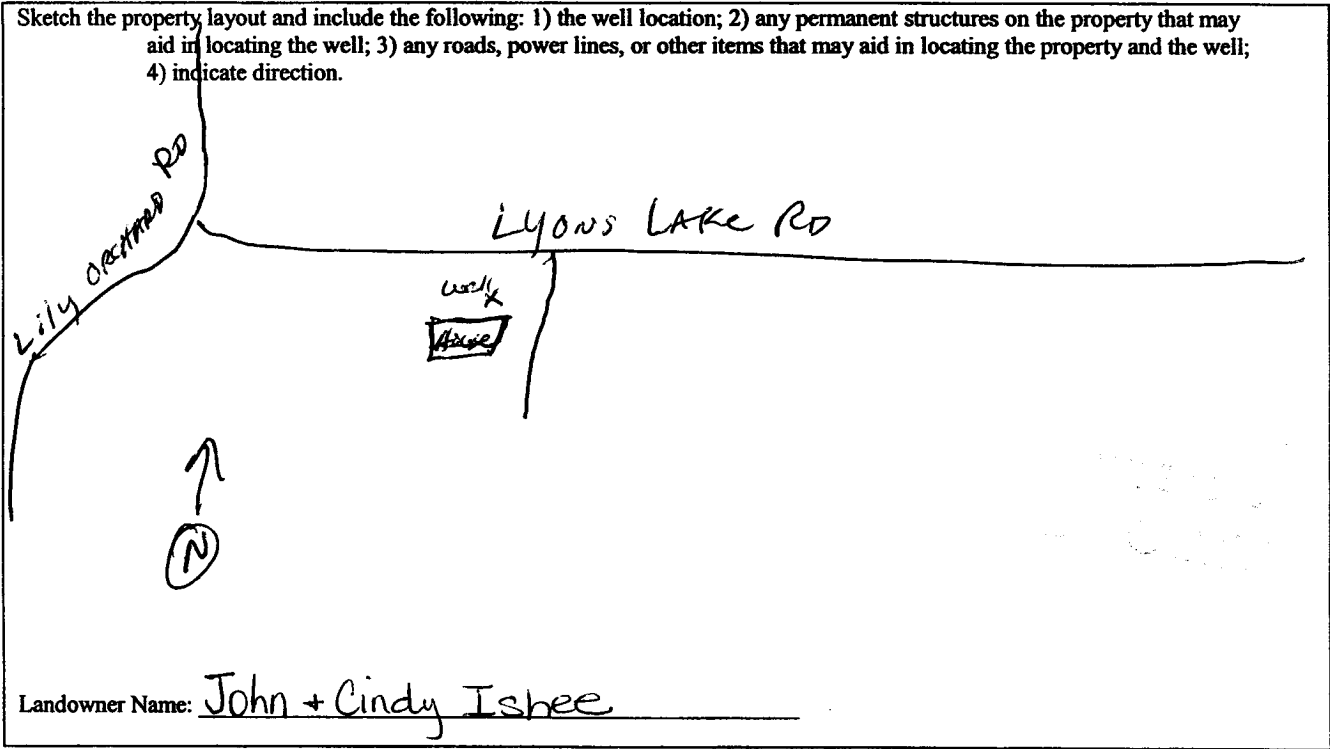


 Signature of Water Well Contractor

STATE WELL REPORT

Part 2

Pump Installer's Completion Report
 Mississippi Department of Environmental Quality
 Office of Land and Water Resources
 P.O. Box 10631
 Jackson, MS 39289-0631
 (601)961-5210
 (601)354-6938 (fax)

For Office Use Only:

Aquifer: _____

Well #: M-422

Elevation: _____

County: Jackson 059
 Permit #: _____
 Driller: Coast Water Well Service
 Date completed: 1-4-05

Coast Water Well Service Inc

This report should be prepared by the pump installer in detail and filed with the Department within 30 days of the installation of pump.

Well Owner Information	Well Location
Owner Name: <u>John + Cindy Ishlee</u>	Latitude: <u>30° 29' 783"</u> Longitude: <u>088° 41' 876"</u>
Mailing Address: <u>9600 Lyons Lake</u>	Method of Lat/Long (circle one): Conventional Survey, USGS quad, <u>Hand-held GPS</u> Survey-grade GPS
<u>Moss Point MS 39562</u> City State Zip Code	<u>SW 1/4 NE 1/4 Sec 23 Twn T6S Rng R5W</u>
Telephone No. <u>(228) 475-0417</u>	Distance Direction Nearest Town <u>3 Miles EAST of Helena</u>

Pump Type Circle one	Power Type Circle one
Air Lift <input type="radio"/> Jet <input checked="" type="radio"/> Submersible	Diesel Engine Gasoline Engine Natural Gas
Bucket <input type="radio"/> Piston <input type="radio"/> Turbine	<u>Electric Motor</u> <input type="radio"/> Hand <input type="radio"/> Tractor PTO
Centrifugal <input type="radio"/> Rotary <input type="radio"/> Flowing Well	Windmill Other (specify): _____
Other (specify): <u>1/2 HP</u>	Horse Power Rating of Motor: <u>1/2 HP</u>
Date Pump Installed: <u>1-27-05</u>	Setting Depth: <u>30' Droppipe</u> feet
Rated Pump Capacity: <u>7.5</u> Gallons Per Minute	Number of Stages: <u>1</u>

Pump Test Data	Method of Measuring Water Level Circle one
Date Well Tested: <u>1-27-05</u>	<u>Air Line</u> <input type="radio"/> Electric Measuring Line <input type="radio"/> Steel Tape <input type="radio"/>
Static Water Level (A): <u>10</u> Feet Below Land Surface	Other (specify): _____
Pumping Water Level (B): <u>N/A</u> Feet Below Land Surface	For flowing well, measured shut in head: <u>N/A</u> feet
Drawdown [(B) - (A)]: <u>N/A</u> Feet Below Land Surface	Well yielded <u>7.5</u> GPM with a drawdown of
Test Pumping Rate: <u>7.5</u> Gallons Per Minute	<u>N/A</u> feet after <u>N/A</u> hours of pumping
Duration of Pump Test (minimum 4 hours): <u>4</u> hours	

I HEREBY CERTIFY that the above statements are true to the best of my knowledge.

Johnny Elkins 0-716P _____
 Print Name of Pump Installer and License No. (if applicable) Signature of Pump Installer

RECEIVED
 MAR 10 2005
 BY: OLWR