Purt 2 never-received 3/13 State W	ell Report	
		For Office Use Only:
County: JACKSON Part 1 Mississippi Department of Environmental Quality		Aquifer:
Permit #: Office of Land and Water Resources		Well #: M- 447
( Deviller) INANT LANATTE INTENSING	P.O. Box 10631 Jackson, MS 39289-0631	
Date drilling completed: $4 - \partial 9 \partial q$ (601)!	<i>Oa</i> (601)961-5210	
(601)354-6938 (fax)		E-log #:
State Law requires that this report be prepared by the driller in detail and filed with the Department within 30 days of completion of drilling of the well.		
Well Owner Information	Well	Location
Owner Name BODDY JOHNS	Latitude: 30 • 32 · 510	" Longitude: 088 ° 27 ' 622"
Mailing Address: 8833 AUGUSta Pd.	Method of Lat/Long (circle or	e): Conventional Survey,
<u> </u>	USGS quad, Hand-held	
moss point MS 39562	State Zip Code	
Telephone No. (208) 475-435.6	Distance Direction	Nearest Town of Helen A
Well Data		
Purpose of Well (circle one) Home Industrial Public Supply Irrigation Fish Culture Other:		
Date well drilling started: $4-29-00$ Date well drilling completed: $4-29-00$		
If flowing, method of flow regulation: Valve <u>NIA</u> Other (describe)		
Static Water Level: 5feet above or below)(circle one) land surface Date measured: 4-29-00		
Method of Measurement (circle one) steel tape electric tape air line other:		
Hole depth: Well depth: Well grouted to a depth of feet		
Type of grout (circle one): Cement Bentonite Mix		
Casing length: 50_feet Casing diameter: 2_inches Type of casing: DVC		
Screen length:		
Screen slot size:		
Type of completion (circle all applicable): Gravel packed Underreamed Telescoped Open hole Natural Development		
Other (describe):		
Top of lap pipe or reduction in casing:feet. If telescoped or more than one screen, describe on back of page		
Logs run (circle all applicable): No log run Electric Gamma Ray Density Sonic Neutron Other:		
Name of organization running log(s): NIA		
I certify that the well was drilled, constructed, and completed in accordance with all applicable requirements of the Mississippi		
Department of Environmental Quality and/or the Mississippi Department of Health regulations and state laws.		
Jack Ridgdell 0-473 Canh hilledere		
Print Name of Water Well Contractor and License No.	Signature of	Water Well-Contractor

• • • . .

MAY 17 2006


BY: OLWR

M- 447

If well telescopes please sketch below and show depths.

**Description of Formations Encountered** From Ground Level sesand

If more than one screen, show location of each on sketch

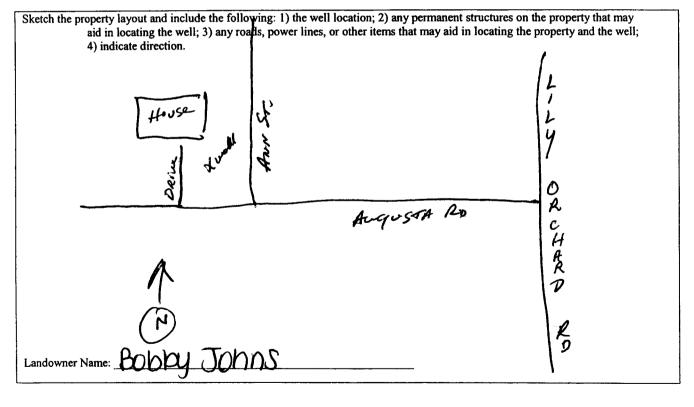

due Signature of Water Well Contractor

MAY 17 2006

RECEIVED

BY: OLWR