| State W | ell Report | | | | |
|---|---|-----------------------------------|--|--|--|
| Country Tockson Part 1 | | For Office Use Only: | | | |
| Mississippi Department | Mississippi Department of Environmental Quality | | | | |
| | nd Water Resources ox 10631 | Well #: <u>M-456</u> | | | |
| Driller UST WUTU WELL SKV · Jackson, M | IS 39289-0631 | L. S. Elevation: | | | |
| | 961-5210 | | | | |
| (601)354 | 1-6938 (fax) | E-log #: | | | |
| State Law requires that this report be prepared by the 30 days of completion of drilling of the well. | | | | | |
| Well Owner Information | | Location | | | |
| Owner Name DOUG + Sharon Susser | Latitude: 080 32 '351 | " Longitude 088 30, 347 | | | |
| Mailing Address: 13672 Hwy 613 | Method of Lat/Long (circle or | ne): Conventional Survey, | | | |
| | USGS quad, Hand-held | GPS, Survey-grade GPS | | | |
| MOSSIDINI MS 39562 City State Zip Code | 5W 1/4 NE 1/4 Sec 8 | Twn TBS Rng R5W | | | |
| Telephone No. <u>208</u> 475 - 6873 | Distance Direction | of Big Point | | | |
| Well I | Data | | | | |
| Purpose of Well (circle one Home) Industrial Public Supply | Irrigation Fish Culture | Other: | | | |
| Date well drilling started: 6-30-06 Date w | vell drilling completed: | 2-30-06 | | | |
| If flowing, method of flow regulation: Valve N/A Other (d | escribe) | | | | |
| Static Water Level: <u>20</u> feet above on below scircle one) land surface Date measured: <u>6-30-06</u> | | | | | |
| Method of Measurement (circle one) steel tape electric tape | air line other: | | | | |
| Hole depth: Well depth: | Well grouted to a depth of | 10feet | | | |
| Type of grout (circle one): Cement Bentonite Mix | | | | | |
| Casing length: 184 feet Casing diameter: 2 | inches Type of casing: | PVC | | | |
| Screen length: <u> </u> | | | | | |
| Screen slot size: 1008 inches Setting depth: From 184 feet to 194 feet | | | | | |
| Type of completion (circle all applicable): Gravel packed Underreamed Telescoped Open hole Atural Development | | | | | |
| Other (describe): | | | | | |
| Top of lap pipe or reduction in casing: | | | | | |
| Logs run (circle all applicable) No log run Electric Gamma Ray Density Sonic Neutron Other: | | | | | |
| Name of organization running log(s): N/A | accordon co | a requirements of the Mississiani | | | |
| - | I certify that the well was drilled, constructed, and completed in accordance with all applicable requirements of the Mississippi | | | | |
| Department of Environmental Quality and/or the Mississippi Department of Health regulations and state laws. | | | | | |
| Jack Kidgdell 0-472 | _ Jah | 1 higher | | | |
| Print Name of Water Well Contractor and License No. | Signature of | f Water Well Contractor | | | |
| | V | | | | |

, , **t** ,

.

JUL 2 5 2006 BY: OLWR


M-456

If well telescopes please sketch below and show depths.

Ground Level

| evel | Description of Formations Encountered | From | 10 |
|------|---------------------------------------|----------|---------------|
| | Topsoil | | a |
| | Brown Clay | $\Box a$ | 60 |
| | White Coarse Sand, | 60 | IIS |
| | Blueclar | 115 | 165 |
| - | Gray Course Sand | 165 | 794 |
| | | | |
| | | | |
| | | | +-+ |
| | | | ├ ───┤ |
| | | | |
| | | | |
| | | | |
| | | | |
| | | | \vdash |
| 1 | | | |
| | | | |
| | | | |
| | | L | L |

If more than one screen, show location of each on sketch

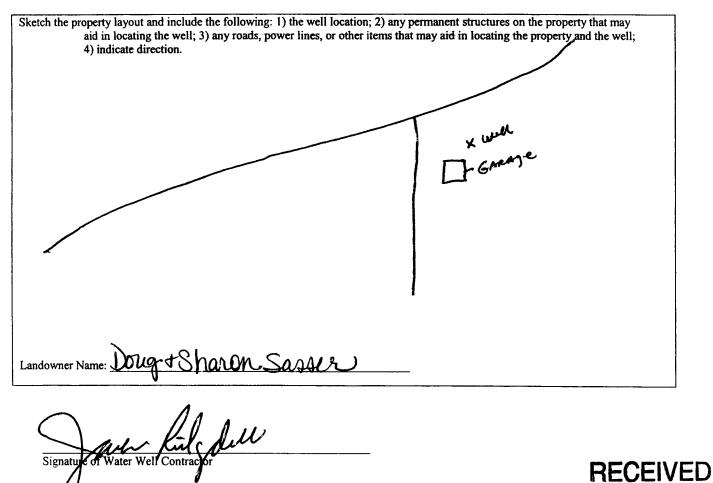

JUL 2 5 2006 BY: OLWR

| | STATE WE | LL REPOR | Т | | | |
|--|---|--|----------------|--------------------|--------------------|---------|
| County: JackSOM | Part 2 Pump Installer's Completion Report Mississippi Department of Environmental Quality Office of Land and Water Resources | | t Juality | Aquifer: | ice Use Only: | |
| Driller: COastWater Well SRV. | P.O. Box 10631 Jackson, MS 39289-0631 | | | Well #: | 1.456 | |
| Date completed: 6-30-06 | | 961-5210 4-6938 (fax) | | Elevation: | | |
| This report should be prepared by the | pump installer in deta | il and filed with the | Department | within 30 da | ys of the | |
| installation of pump. Well Owner Informatio | <u>n</u> | | Well I | ocation | <u> </u> |] |
| Owner Name: Doug + Sharon Sa | sser | Latitude 30 32 | <u>'329</u> 1 | ongitude: 💋 | <u>88°30'34</u> 74 | |
| Mailing Address: 13672 Huy (| 13 | Method of Lat/Lon | g (circle one) | : Convention | al Survey, | |
| | <u>-</u> | USGS q | uad, Hand-h | eld GPS Sur | vey-grade GPS | |
| Moss foint M | <u>S 39562</u> Zip Code | SW 1/ NE | 4 Sec <u>8</u> | | Rng £5 W | |
| City State | Lip coue | Distance D | Direction | Nearest To | wn | |
| Telephone No. (228) 475 - 6873 | 3 | <u></u> | _of_ | Bigk | BINT | |
| Pump Type Circle one | | | | er Type ele one | |] |
| Air Lift Jet | Submersible | Diesel Engine | Gasoline | Engine | Natural Gas | |
| Bucket Piston | Turbine | Electric Motor | Hand | | Tractor PTO | |
| Centrifugal Rotary | Flowing Well | Windmill | | ecify): | | |
| Other (specify): | | Horse Power Ratin | g of Motor: _ | 1HP GI | oulds | |
| Date Pump Installed: 7-5-06 | | Setting Depth: 4 | OFT. D | <u>oppip</u> | Sfeet | |
| Rated Pump Capacity:9 | Gallons Per Minute | Number of Stages: | | え | | |
| Pump Test Data | | Met | | uring Water | Level |] |
| Date Well Tested:7-5-06 | | | | | | |
| Static Water Level (A): <u>20</u> Feet B | elow Land Surface | Air Line E Other (specify): | lectric Measu | - | Steel Tape | |
| Pumping Water Level (B):Feet B | elow Land Surface | Other (specify). | | | | |
| Drawdown [(B) - (A)]: Feet B | elow Land Surface | For flowing well, r | neasured shu | t in head: | NA feet | |
| Test Pumping Rate: | Gallons Per Minute | Well yielded | - | GPM with a | drawdown of | |
| Duration of Pump Test (minimum 4 hours): | hours | N/A | feet after _ | 5//Ah | ours of pumping | |
| I HEREBY CERTIFY that the above stateme Ben Ridgdell 0-7 Print Name of Pump Installer and License No | 13P | of my knowledge. <u>B.s.</u> Signature | R.d. | aller | RECEIV |] /E |
| | | | | | JUL 2 5 2 | 200 |

· · · · ,

| BY: | 0 | LV | V | R |
|-----|---|----|---|---|