Current of the construction of the construle of the construction of the construction of the con	Rut 2 never received 3/13 State W	all Donort				
County: JUCKSCY Permit #		- 1	For Office Use Only:			
Permit #:						
Driller (DQS+Wd+er-Ukel)[SR/. P.O. Box 10631 Jackson, MS 39289-0631 (601)354-0938 (fax) Well #:	Permit #: Office of Land a	nd Water Resources	•			
Date drilling completed: State Law requires that this report be prepared by the driller in detail and filed with the Department within 30 days of completion of drilling of the well. I. S. Bievation: Bate drilling completed: State Law requires that this report be prepared by the driller in detail and filed with the Department within 30 days of completion of drilling of the well. Well Overal Information Well Overal Information Well Overal Information Well Overal Information Owner Name John BCach Initide:: 30.31			Well #:			
(601)354-6938 (fax) State Law requires that this report be prepared by the driller in detail and filed with the Department within 30 days of completion of drilling of the well. Well Owner Information Owner Name John Roach Mailing Address: Bird LAKERd. Well Owner Information Well Owner Information Well AKERd. Well AKERd. Mailing Address: Bird LAKERd. Well Owner Information Well Ake Rd. Matheware John Roach Mailing Address: Bird LAKERd. Well Owner Information Well Address: Direction Report be prepared by the driller in detail and filed with the Department within 30 days of completion of the Well. Mailing Address: Bird LAKERd. Well Carte Completion Content Content State	Jackson, M		L. S. Elevation:			
State Law requires that this report be prepared by the driller in detail and filed with the Department within 30 days of completion of drilling of the well. Well Owner Information Owner Name JOhn Reach Mailing Address:	Date drilling completed: <u>8-10-(26</u> (601)		F 1 #			
30 days of completion of drilling of the well. Well Coaction Owner Name_JOhn RCOCh	(601)354	4-0938 (Iax)	E-log #:			
Well Owner Information Well Location Owner Name_JOAN BCOCA		driller in detail and filed wi	ith the Department within			
Mailing Address: Bird LAKERd. Mailing Address: Bird LAKERd. Mailing Address: Method of LavLong (circle one): Conventional Survey. Mailing Address: Method of LavLong (circle one): Conventional Survey. Mailing Address: Method of LavLong (circle one): Conventional Survey. Mailing Address: Method of LavLong (circle one): Conventional Survey. Mailing Address: Method of LavLong (circle one): Conventional Survey. Mailing Address: Method of LavLong (circle one): Conventional Survey. Telephone No. (2083) 475-0538 Disappee Well Data Disappee Purpose of Well (circle one) (Home: Industrial Industrial Public Supply Irrigation Purpose of Well (circle one) (Home: Industrial If flowing, method of flow regulation: Valve Method of Measurement (circle one) stel tape Of grout (circle one): Cenent Method of Measurement (circle one): Stel tape Mix Casing length: Tappic feet Screen slot size: COS inches Type of grout (circle all applicable): Gravel packed Underneamed Top of lap pipe		Well	Location			
USGS quad, tand-held GPS Survey-grade GPS MOSS POINT MS 39.562 $MSGS$ quad, tand-held GPS Survey-grade GPS Telephone No. DSS 9475-0538 Direction Negrest Town Well Data Purpose of Well (circle one) Home) Industrial Public Supply Irrigation Fish Culture Other:	Owner Name_John Roach	Latitude: <u>30 31 992</u>	" Longitude: <u>088. 27. 110</u> "			
$\frac{MOSSPOINTMS 39562}{City State ZipCode}$ $\frac{SW & SE & M & Sec MV & Twn 76 & Rng RSW}{State ZipCode}$ $\frac{SW & SE & MV & Sec MV & Twn 76 & Rng RSW}{State State ZipCode}$ $\frac{SW & Sec MV & Sec MV & Twn 76 & Rng RSW}{State State S$	Mailing Address: Bird LAKERd.	Method of Lat/Long (circle on	e): Conventional Survey,			
City State Zip Code Telephone No. (DS) 475-0538 Well Data Purpose of Well (circle one) Home Industrial Public Supply Irrigation Fish Culture Other: Date well drilling started: A Date well drilling completed: A If flowing, method of flow regulation: Valve Other (describe) Static Water Level: feet above or below & Circle one) land surface Date measured: Hole depth: Well depth: Well grouted to a depth of feet Type of grout (circle one): Cement Bentonite Mix Casing length: feet Casing diameter: inches Type of casing: Screen length: feet Screen diameter: inches Type of screen: Screen slot size: OOB inches Setting depth: From feet to feet Type of completion (circle all applicable): Gravel packed Underreamed Telescoped Open hole Natural Development Other (describe): Top of lap pipe or reduction in casing: feet. If telescoped or more than one screen, describe on back of page Logs run (circle all applicable): No log run) Electric Gamma Ray Density Sonic Neutron Other: Name of organization running log(s): Jack Ridaddell 0-4772 Method Maxeumental Quality and/or the Mississippi Department of Health regulations and state laws. 						
Well Data Purpose of Well (circle one) Industrial Public Supply Irrigation Fish Culture Other:	MOSS POINT MS 39562 City State Zip Code	SW 1/4 SE 1/4 Sec_ / /V	Twn T6 S Rng R5W			
Purpose of Well (circle one) Home Industrial Public Supply Irrigation Fish Culture Other:		Distance Direction	Nearest Town of Helena			
Purpose of Well (circle one) Home Industrial Public Supply Irrigation Fish Culture Other:	Well I	l Data				
Date well drilling started: 8-10-00 Date well drilling completed: 8-10-06 If flowing, method of flow regulation: Valve Static Water Level: 5 feet above or below(circle one) land surface Date measured: 8-10-06 Method of Measurement (circle one) steel tape electric tape air line other:						
If flowing, method of flow regulation: Valve N/A Other (describe)						
Static Water Level: 5 feet above or below (circle one) land surface Date measured: 8-10-06 Method of Measurement (circle one) steel tape electric tape air line other: Hole depth: BD' Well depth: BD' Well grouted to a depth of 10 Type of grout (circle one): Cernent Bentonite Mix Casing length: 72 feet Casing diameter: Q inches Type of casing: PVC Screen length: 10 feet Screen diameter: Q inches Type of screen: PVC Screen slot size: • 008 inches Setting depth: From 7Q feet to 8Q feet Type of completion (circle all applicable): Gravel packed Underreamed Telescoped Open hole Natural Development) Other (describe):						
Method of Measurement (circle one) steel tape electric tape air line other:						
Hole depth: Sh' Well depth: Sh' Well grouted to a depth of 10	Static Water Level:feet above or below (circle one) I	\sim				
Type of grout (circle one): Cement Bentonite Mix Casing length: 72 feet Casing diameter: 2 inches Type of casing: PVC Screen length: 10 feet Screen diameter: 2 inches Type of screen: PVC Screen length: 10 feet Screen diameter: 2 inches Type of screen: PVC Screen slot size: • 008 inches Setting depth: From 72 feet to 82 feet Type of completion (circle all applicable): Gravel packed Underrearned Telescoped Open hole Natural Development Other (describe):						
Casing length:	Hole depth: Well depth:	Well grouted to a depth of	feet			
Screen length: 10 feet Screen diameter:	Type of grout (circle one): Cement Bentonite Mix					
Screen slot size: 008 inches Setting depth: From	Casing length: <u>72</u> feet Casing diameter: <u>2</u>	inches Type of casing:	<u>pvc</u>			
Type of completion (circle all applicable): Gravel packed Underreamed Telescoped Open hole Natural Development Other (describe):	Screen length: <u>10</u> feet Screen diameter: <u></u>		<u>Pvc</u>			
Other (describe):	Screen slot size:	<u>72</u> feet to <u>8</u>	<u>feet</u>			
Top of lap pipe or reduction in casing: N/A feet. If telescoped or more than one screen, describe on back of page Logs run (circle all applicable): No log run Electric Gamma Ray Density Sonic Neutron Other: Name of organization running log(s): N/A I certify that the well was drilled, constructed, and completed in accordance with all applicable requirements of the Mississippi Department of Environmental Quality and/or the Mississippi Department of Health regulations and state laws. Jack Ridadell 0-472	Type of completion (circle all applicable): Gravel packed Under	reamed Telescoped Open	hole Natural Development			
Logs run (circle all applicable): No log run Electric Gamma Ray Density Sonic Neutron Other:						
Name of organization running log(s): N/A I certify that the well was drilled, constructed, and completed in accordance with all applicable requirements of the Mississippi Department of Environmental Quality and/or the Mississippi Department of Health regulations and state laws. Jack Ridadell 0-472	Top of lap pipe or reduction in casing: N/A feet. If telescoped or more than one screen, describe on back of page					
I certify that the well was drilled, constructed, and completed in accordance with all applicable requirements of the Mississippi Department of Environmental Quality and/or the Mississippi Department of Health regulations and state laws. Jack Ridadell 0-472		Density Sonic Neutron	Other:			
Department of Environmental Quality and/or the Mississippi Department of Health regulations and state laws. Jack Ridadell 0-472	Name of organization running log(s): N/A I certify that the well was drilled, constructed, and completed in accordance with all applicable requirements of the Mississinni					
Jack Ridgdell 0-472 Jack Ridgdell 0-472 Print Name of Water Well Contractor and License No. Signature of Water Well Contractor 2 9 2006						
Print Name of Water Well Contractor and License No. Signature of Water Well Contractor 2 9 2006	Jack Ridgdell 0-472	ail	La BECEIVED			
	Print Name of Water Well Contractor and License No.	Signature of	Water Well Confidence 2 9 2006			

* 7

~

BY:	Οί	WR	
-----	----	----	--


M- 458

BY: OLWR

If well telescopes please sketch below and show depths.

Ground Level	 Description of Formations Encountered	From	
	Blue Clay White Coarse Sand	35	25 83

If more than one screen, show location of each on sketch

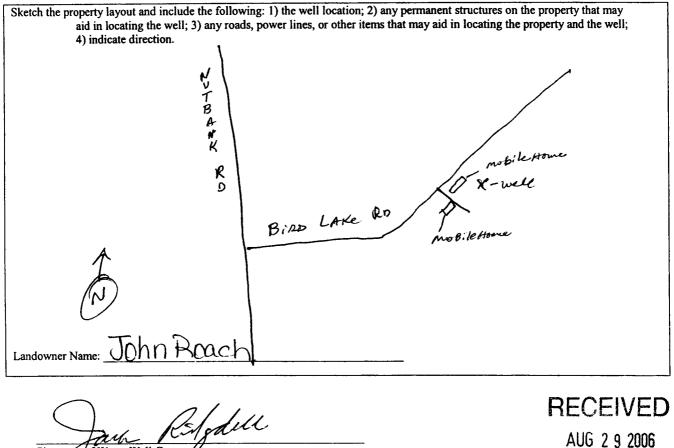

Signature of Water Well Contractor