State W	ell Report				
	For Office Use Only:				
Mississippi Department	Mississippi Department of Environmental Quality Aquifer:				
	nd Water Resources Box 10631 Well #: M-501				
	IS 39289-0631 L. S. Elevation:				
Date drilling completed: $\left[\frac{\partial}{\partial} - \left(\frac{\partial}{\partial r}\right)\right]$ (601)	961-5210				
(601)354	E-log #:				
State Law requires that this report be prepared by the 30 days of completion of drilling of the well.	driller in detail and filed with the Department within				
Well Owner Information	Well Location				
Owner Name Jimmy Vice	Latitude: <u>30 • 38 ·587</u> " Longitude <u>88 • 30 · 343</u> "				
Mailing Address: Ollie Vice Rd	Method of Lat/Long (circle one): Conventional Survey,				
	USGS quad, Hand-held GPS, Survey-grade GPS				
MOSS POINT, MS 37562	NW SO 1/2 SE 1/2 Sec 32 / Twn T6 5 Rng RSW				
Telephone No. <u>28 474-2890</u>	Distance Direction Nearest Town 				
Weil I	Data				
Purpose of Well (circle one) Home Industrial Public Supply	Irrigation Fish Culture Other:				
Date well drilling started: $12-6-07$ Date well drilling completed: $12-6-07$					
If flowing, method of flow regulation: Valve N/A Other (describe)					
Static Water Level: <u>AO</u> feet above of below (circle one) land surface Date measured: <u>13-6-07</u>					
Method of Measurement (circle one) steel tape electric tape air line other:					
Hole depth: 166FT Well depth: 166FT Well grouted to a depth of 10 feet					
Type of grout (circle one): Cement Bentonite Mix					
Casing length: 156 feet Casing diameter: A inches Type of casing: PVC					
Screen length: 10 feet Screen diameter: 2 inches Type of screen: PVC					
Screen slot size: • 008 inches Setting depth: From 156 feet to 166 feet					
Type of completion (circle all applicable): Gravel packed Underreamed Telescoped Open hole Natural Development					
Other (describe):					
Top of lap pipe or reduction in casing: N/A feet. If telescoped or more than one screen, describe on back of page					
Logs run (circle all applicable) No log run Electric Gamma Ray Density Sonic Neutron Other:					
Name of organization running log(s): N/A					
I certify that the well was drilled, constructed, and completed in accordance with all applicable requirements of the Mississippi Department of Environmental Quality and/or the Mississippi Department of Health-regulations and state laws.					
Tack Ridadell N-472	and hil shell				
Den New Well Contraction N					
Print Name of Water Well Contractor and License No.	Signature of Water Well Contractor				

.

*. **-**

•

M-501

fair and a second second


If well telescopes please sketch below and show depths.

Ground Level

٠

Description of Formations Encountered	From	То
TOPSOIL	0	3
White Clay	$\frac{a}{b}$	13
White Coarse Sand Wistreaks (In	1 in	30
Gray Course Sand	136	IL.L
Stagentise Starts	134	100
	ļ	
		_
		_
	ļ	
······································	<u> </u>	
	<u> </u>	
	<u> </u>	

If more than one screen, show location of each on sketch

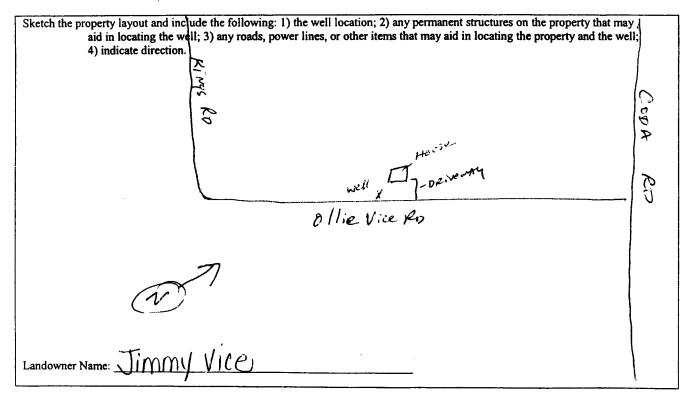

dul

Signature of Water Well Contractor

	STATE W	ELL REPOR	Г	
County: JACKSON Permit #: Driller COAST WATER Well SRV. Date completed: 13-6-07	Pump Installer ¹ Mississippi Departme Office of Land P.O. Jackson, I (601	Part 2 s Completion Report nt of Environmental Q and Water Resources Box 10631 MS 39289-0631 0961-5210 64-6938 (fax)	uality Aqui Well	For Office Use Only: fer: #:50
This report should be prepared by the installation of pump.	pump installer in det	ail and filed with the l	Department with	in 30 days of the
Well Owner Information Owner Name: Jimmy Vice Mailing Address: Ollie Vice Re	1. <u>)S 395/a</u> 2 Zip Code	Method of Lat/Long USGS qu <u>کر سنگ SF</u> y Distance Di	(circle one): Con nad, fland-held G Sec_32Tw irection Ne	rude: <u>(188[°] 30' 34</u> 2"
Ритр Туре		[6	Power Ty	
Circle one	Submersible	Direct Franks	Circle one	
\bigcirc	Submersible	Diesel Engine Electric Motor	Gasoline Engin Hand	e Natural Gas
Centrifugal Rotary Other (specify):		Windmill Horse Power Rating Setting Depth: <u>4</u> Number of Stages: _	of Motor: _/	
Pump Test Data	·····	Meth	od of Measuring Circle one	
Pumping Water Level (B): $\underline{N A}$ Feet Be Drawdown [(B) – (A)]: $\underline{N A}$ Feet Be	elow Land Surface low Land Surface low Land Surface allons Per Minute	Other (specify): For flowing well, me Well yielded	ctric Measuring L	ine Steel Tape
I HEREBY CERTIFY that the above statemen Johnny Elkins 0-71 Print Name of Pump Installer and License No.	69	John Elhon	Pump Installer	

•

-