
State W	ell Report	The Office Has Only		
County: Jackson P.	art 1	For Office Use Only:		
Mississippi Department	t of Environmental Quality	Aquifer:		
	nd Water Resources	Well #: M-509		
notified by the table to tab	Sox 10631			
Jackson, M	IS 39289-0631	L. S. Elevation:		
Date driving verification	961-5210 4-6938 (fax)	E-log #:		
	- 1			
State Law requires that this report be prepared by the	driller in detail and filed w	ith the Department within		
30 days of completion of drilling of the well.				
Well Owner Information		Location OSC 200		
Owner Name LEFFIE WILKS	Latitude: 30 • 27 67	Congitude U00 (1) 1/5		
Mailing Address: Wadow View D.	Method of Lat/Long (circle or	ne): Conventional Survey,		
		GPS, Survey-grade GPS		
MOSS HOINT MS 39562 City State Zip Code	NE 1/2 56 1/2 Sec_ 30	Twn 185 Rng R5 W		
Telephone No. 2008 (023 - 4785	Distance Direction 2/2 Miles West	Nearest Town of televa		
Well I)ata			
Purpose of Well (circle on Home Industrial Public Supply Irrigation Fish Culture Other:				
Date well drilling started: 4-24-08 Date well drilling completed: 4-24-08				
If flowing, method of flow regulation: Valve Other (d				
Static Water Level:feet above o below (circle one) land surface Date measured:4-34-08				
Method of Measurement (circle one) steel tape electric tape air line other:				
Hole depth: 249 FT Well depth: 349 FT Well grouted to a depth of 10 feet				
Type of grout (circle one): Cement Bentonite Mix		0.16		
Casing length: 25° feet Casing diameter: 2	inches Type of casing:	PUC		
Screen length: O feet Screen diameter: O inches Type of screen:				
Screen slot size:, OCCinches				
Type of completion (circle all applicable): Gravel packed Underreamed Telescoped Open hole Natural Development				
Other (describe):				
Top of lap pipe or reduction in casing:feet. If telescoped or more than one screen, describe on back of page				
Logs run (circle all applicable): No log run Electric Gamma Ray Density Sonic Neutron Other:				
Name of organization running log(s): I certify that the well was drilled, constructed, and completed in accordance with all applicable requirements of the Mississippi				
Department of Environmental Quality and/or the Mississippi Department of Health regulations and state laws.				
Jack Ridgdell 0-472 Jack Ridgden				
Print Name of Water Well Contractor and License No. Signature of Water Well Contractor Signature of Water Well Contractor				
		Seems from Syrum I Summer County		

If well telescopes please sketch below and show depths.

Ground Level		

Description of Formations Encountered	From	To
Topsoil		
Gray Clay	\mathbf{a}	13
White Coarse Fand w streaks if Clay	IS	70
Blueclay	70	120
white course sand	190	140
Blueclay	140	235
Gray Medium Sand	235	244
		<u> </u>
		
		
	 	
		
	L	L

If more than one screen, show location of each on sketch

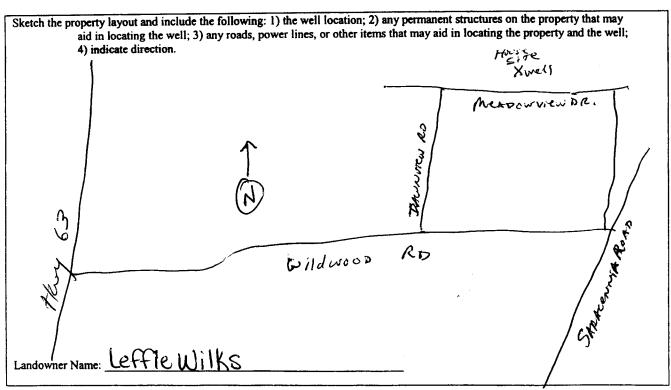

Signature of Water Well Contractor

RECEIVED

MAY 1 4 2008 RY: OLWR

STATE WELL REPORT

Jackson Date completed:

Part 2

Pump Installer's Completion Report Mississippi Department of Environmental Quality Office of Land and Water Resources P.O. Box 10631 Jackson, MS 39289-0631 (601)961-5210

For Office Use Only:		
Aquifer:		
Well #: M-509		
Elevation:		

(601)354-6938 (fax) This report should be prepared by the pump installer in detail and filed with the Department within 30 days of the installation of pump. Well Owner Information Well Location Longitude: \mathcal{U} Method of Lat/Long (circle one): Conventional Survey, Mailing Address: USGS quad, (Hand-held GPS, Survey-grade GPS Distance Direction Nearest Town Telephone No. 208 Pump Type Power Type Circle one Circle one Air Lift Submersible Diesel Engine Gasoline Engine Natural Gas **Bucket** Piston Turbine Electric Motor Hand **Tractor PTO** Centrifugal Rotary Flowing Well Windmill Other (specify): Other (specify): Horse Power Rating of Motor: Date Pump Installed: 4-25-08 Rated Pump Capacity: Gallons Per Minute Number of Stages: **Pump Test Data** Method of Measuring Water Level Circle one -25-08 Date Well Tested: Air Line Electric Measuring Line Steel Tape Static Water Level (A): Feet Below Land Surface Other (specify): Pumping Water Level (B): NA Feet Below Land Surface Drawdown $\{(B) - (A)\}$: Feet Below Land Surface For flowing well, measured shut in head: Test Pumping Rate: Gallons Per Minute _GPM with a drawdown of Duration of Pump Test (minimum 4 hours): hours of pumping

I HEREBY CERTIFY that the above statements are true to the b	est of my knowledge.
John Elkins O-469	Un Elm
Drint Nome of Dynam Lentelles and Linear No. (C. 1: 11.)	7 7

Print Name of Pump Installer and License No. (if applicable)

Signature of Pump Installer