State W	For Office Use Only:			
	'art l			
	and Water Resources			
poille metulater Wellsky P.O.I	Box 10631 Well #: $1 < 0.5 < 0.5$			
Jackson, N	AS 39289-0631 L. S. Elevation: 961-5210			
(601) 35	E-log #:			
State Law requires that this report be prepared by the 30 days of completion of drilling of the well.	driller in detail and filed with the Department within			
Well Owner Information	Well Location			
Owner Name Jaime Barfield	Latitude: $30 \cdot 32 \cdot 045$ " Longitud $285 \cdot 30 \cdot 385$ "			
Mailing Address: 5801 Slater Circle	Method of Lat/Long (circle one): Conventional Survey, 23°			
	USGS quad, Hand-held GPS Survey-grade GPS			
City State Zip Code	X X Sec 8 V Twn T 6 5 V Rng R 5 W			
Telephone No. 008 990 - 9334	Distance Direction Nearest Town <u><u><u></u></u>Miles <u>Source</u> of <u>Big Point</u></u>			
Weil	Data			
Purpose of Well (circle one Home Industrial Public Supply Irrigation Fish Culture Other:				
Date well drilling started: $5/15/09$ Date well drilling completed: $5/15/09$				
If flowing, method of flow regulation: ValveA Other (d	lescribe)			
Static Water Level: 30_feet above or below (circle one) land surface Date measured: 5/15/09_				
Method of Measurement (circle one) steel tape electric tape air line other:				
Hole depth: <u>204FT</u> . Well depth: <u>204FT</u> Well grouted to a depth of <u>(</u>) feet				
Type of grout (circle one): Cement Bentonite Mix				
Casing length: <u>194</u> feet Casing diameter: <u>A</u> inches Type of casing: <u>PVC</u>				
Screen length: 0 feet Screen diameter: 2 inches Type of screen: PVC				
Screen slot size: <u>• OO 4</u> inches Setting depth: From _	feet to 204 feet			
Type of completion (circle all applicable): Gravel packed Underreamed Telescoped Open hole Natural Development				
Other (describe):				
Top of lap pipe or reduction in casing: feet. If telescoped or more than one screen, describe on back of page				
Logs run (circle all applicable) No log run Electric Gamma Ray Density Sonic Neutron Other:				
Name of organization running log(s): NA I certify that the well was drilled, constructed, and completed in accordance with all applicable requirements of the Mississippi				
I certify that the well was drilled, constructed, and completed in accordance with all applicable requirements of the Mississippi Department of Environmental Quality and/or the Mississippi Department of Health regulations and state laws.				
Tack Ridadoll 0-477	A. I. Red. No. D.			
Print Name of Water Well Contractor and License No.	Signature of Water Well Contractor			
	MAY 2 6 2009			

. * * *


BY: OLWR

if well telescopes please sketch below and show depths.

G

Ground Level	Description of Formations Encountered	ption of Formations Encountered From		
	TopSoil	0	2	
	Orange Clay	a	15	
	White Cearse Sand	ITS	20	
	Bluerlay	20	\mathcal{T}	
	inhite norse sand	60	120	
	Rive clay	120	180	
	Gray Medium Sand	180	act	
	Citay Ireanar 1 Set D			
		-+		
			·	
				
			/	

If more than one screen, show location of each on sketch

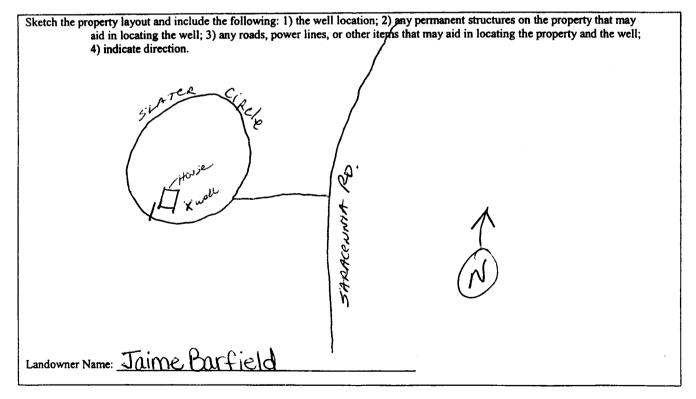

flell

Signature of Water WellContractor

RECEIVED MAY 2 6 2009 **BY: OLWR**

	STATE WH	ELL REPORT			
County: Jackson	Part 2 Pump Installer's Completion Report Mississippi Department of Environmental Quality Office of Land and Water Resources P.O. Box 10631 Jackson, MS 39289-0631 (601) 961-5210		For Office Use Only: Aquifer:		
Drille COAST WATER WELLSRV. Date completed: 5/15/09			Well #: <u>M536</u> Elevation:		
Date completed:					
Well Owner Informati	on	r i i i i i i i i i i i i i i i i i i i	Location		
Owner Name: Juine Burfield		Latitude: 3032 045	titude: <u>30°32'045</u> " Longitude: <u>085°30'38</u> 8"		
Mailing Address: 5801 Slater Ci	rcle	Method of Lat/Long (circle on	hod of Lat/Long (circle one): Conventional Survey,		
		USGS quad, Hand-held GPS? Survey-grade GPS			
Mossfoint MS 39562 City State Zip Code			Twn TOS Rng RSW		
City State	Dip Couc	Distance Direction	Nearest Town		
Telephone No. (208) 990-9334		<u> </u>	Big Point		
Pump Type Circle one			wer Type ircle one		
Air Lift Oet	Submersible	Diesel Engine Gasolin	e Engine Natural Gas		
Bucket Piston	Turbine	Electric Motor Hand	Tractor PTO		
Centrifugal Rotary	Flowing Well	Windmill Other (specify):		
Other (specify):		Horse Power Rating of Motor:	<u>1 HP</u>		
Date Pump Installed:		Setting Depth: <u>40FT. Drop pipe</u> seet			
Rated Pump Capacity:	Gallons Per Minute	Number of Stages:	2		
Pump Test Data			asuring Water Level rcle one		
Date Well Tested:5//8/09 Static Water Level (A):70Feet H	Below Land Surface	Air Line Electric Meas	suring Line Steel Tape		
Pumping Water Level (B): <u>N/A</u> Feet B	elow Land Surface	Other (specify):			
Drawdown [(B) – (A)]: N/A Feet B	Below Land Surface	For flowing well, measured sh	ut in head: NA feet		
Test Pumping Rate:	Gallons Per Minute	Well yielded	GPM with a drawdown of		
Duration of Pump Test (minimum 4 hours):	<u>5</u> hours	N/A feet after	N/A hours of pumping		
I HEREBY CERTIFY that the above stateme <u>Jack Ridgdell</u> 0-478 Print Name of Pump ⁴ Installer and License No	k		staller RECEIVE		

.

MAY 2 6 2009

BY: OLWR