

~~7-27~~

FORM 2006 WATER WELL DRILLERS LOG

8-4-60

Date: 8/4, 1960, Driller: Colville Water Supply Co. County Jackson

(1) Owner of Land: RR Gasaway
 (Name)
 Eseatampa Miss
 (Address)

(2) Location: NW 1/4, SE 1/4, Sec. 9 T6R5W
 _____ miles _____ of _____
 (distance) (direction) (Nearest Town)

(3) Topography: _____
 (Hilly) (Flat) (Level)

(4) Purpose of Well: Domestic
 (Domestic Irrigation
 Municipal, Industrial, Other)

Description & Color of Materials Sand, Clay, Red Clay, Shell, etc.	Thick- ness Feet	Depth Feet
0 yellow clay	12	12
28 Sand	50	78
121 Sand	165	199
189		

Information upon completion of well:

(1) Diameter 1 1/4 inches.

(2) Total Depth 189 feet.

(3) Water Level 10.5 feet below top of ground.

(4) Cased to None, Size _____

(5) Screen: Size 1 1/4, Length 5'

(6) Were any formations sealed against pollution?
 _____ yes, _____ no.

TD 189 Hole

189


10.5

189

If YES depth of formation _____

Why _____

Drillers Remarks: _____

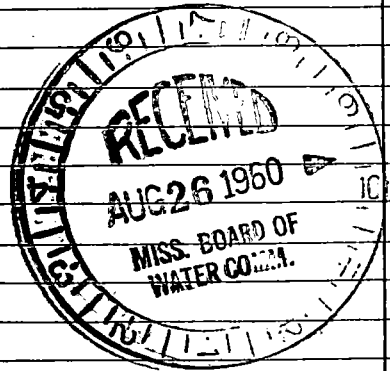

(Use Back Side)

Well No.

