

M 2051

WATER WELL DRILLERS LOG

COLVILLE

8-8-60

Date: 8/8, 1960, Driller: Water Supply Co. County JACKSON

(Name)

(1) Owner of Land: NE Yocom
(Name)
Escatawpa Miss
(Address)

(2) Location: SE 1/4 SW 1/4, Sec. 12 T6SR54W
miles of
(distance) (direction) (Nearest Town)

(3) Topography: (Level)
(Hilly) (Flat)

(4) Purpose of Well: Domestic
(Domestic Irrigation
Municipal, Industrial, Other)

Description & Color of Materials Sand, Clay, Red Clay, Shell, etc.	Thick- ness Feet	Depth Feet
0 Clay + slush	21	Mud
42 Sand gran	105	Mud
147 Mud	182	Mud
245 Sand	252	Mud
294 gritty Mud	315	Mud
335 Sand	347	
	none	

Information upon completion of well:

(1) Diameter 1 1/4 inches.

(2) Total Depth 347 feet. ~~337~~

(3) Water Level 11 feet below top of ground.

(4) Cased to none, Size

(5) Screen: Size 1 1/4 Length 10

(6) Were any formations sealed against pollution?
yes, no.


If YES depth of formation

Why

Drillers Remarks:

347.
- 10

length 337

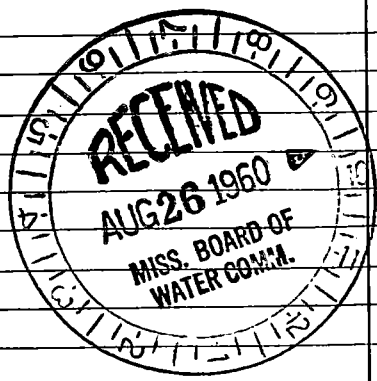

(Use Back Side)

Well No.

