

JACKSON MISSISSIPPI BOARD OF WATER COMMISSIONERS

M 2000  
4-21-66

WATER WELL DRILLERS LOG

Date: 4-21, 1966, Driller: H.O. Rydell County Jackson  
(Name)

(1) Owner of Land: E.H. Burt  
(Name)  
Passapatanz, Miss.  
(Address)  
(2) Location: 1/4, 1/4, Sec. 0 T. 20 R. 65 80  
12 miles N.E. of Passapatanz  
(distance) (direction) (Nearest Town)  
(3) Topography:  Hilly  (Flat)  (Level)  
(4) Purpose of Well: Home  
(Domestic Irrigation  
Municipal, Industrial, Other)


Description & Color of Materials Sand, Clay, Red Clay, Shell, etc.	Thick- ness Feet	Depth Feet
Red Clay	21	21
Blue "	21	42
Hard mud	21	63
" "	10	73
Blue Clay	11	84
Blue sandy shale	21	105
" " "	21	126
" " "	21	147
" " "	21	168
Coarse sand	5	173
		Water

Information upon completion of well:

(1) Diameter 2" inches.  
(2) Total Depth 173 feet.  
(3) Water Level 10 feet below top of ground.  
(4) Cased to \_\_\_\_\_, Size \_\_\_\_\_  
(5) Screen: Size 2", Length 5'  
(6) Were any formations sealed against pollution?  
\_\_\_\_\_ yes,  no.

173  
- 5  
---  
168

If YES depth of formation \_\_\_\_\_  
Why \_\_\_\_\_  
Drillers Remarks: \_\_\_\_\_

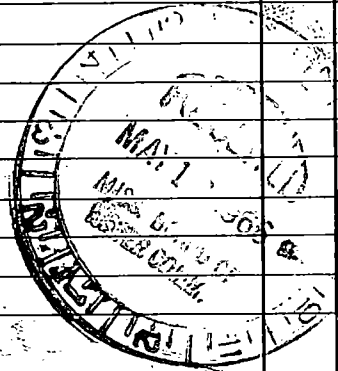

(Use Back Side)

Well No.

