

JACKSON  
 M 2003  
 3-68

MISSISSIPPI  
 BOARD OF WATER COMMISSIONERS  
 416 North State Street  
 Jackson, Mississippi 39201

WATER WELL DRILLERS LOG

3-25-68 date well completed  
 19 COAST WATER WELL SERVICE firm name  
 JACKSON county well located

LANDOWNER: REUS  
Rural Route  
Prigona, Miss.  
 (mailing address)  
 WELL LOCATION:  
 sec. 7 T. 6 N. R. 5 E.  
8 miles N. of Chickasaw  
 (distance) (direction) (nearest town)


description of formations encountered	from	to
RED CLAY	0	12
COARSE SAND	12	18
RED CLAY	18	20
COARSE SANDY GRAVEL	20	127
FINE SAND & SHALE WITH SL. OF CLAY	127	156
MED. SAND	156	178

WELL PURPOSE: HOME  
 (home, irrigation, municipal, industrial)

WELL COMPLETION DATA:  
 (1) diameter (inches) 2"  
 (2) total depth (feet) 178'  
 (3) static water level (feet) 14' <sup>below</sup> above top of ground.  
 (4) casing GALV. 168'  
 (material) (depth)  
2" if telescope see back.  
 (size)  
 (5) screen 10' 168'  
 (length) (depth to top)  
2" STAINLESS STEEL  
 (size) (material)  
 (6) pump \_\_\_\_\_  
 (HP) (yield gpm)  
 (type power)  
 (7) electric log NO  
 (yes or no)  
 (organization running log)

(8) how well bottom plugged 2" BACK  
WASH VALVE

DRILLERS REMARKS:

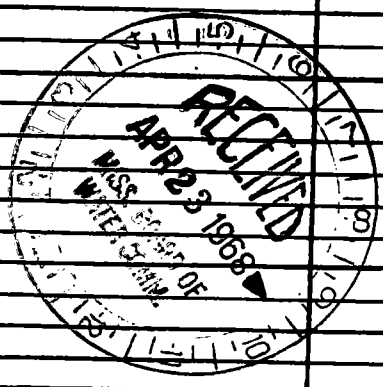

If well telescopes please sketch and show depths.

GROUND LEVEL

X			

SECTION 2

Please indicate well location X.

ADDITIONAL INFORMATION

If more than one screen, show locations of each on sketch.